Addendum No. 2 August 17, 2021

Project: DGR Engineering

Lot 4, Block 19 Dawley Farm Village Addition

2932

Architect: Architecture Incorporated

Letting: August 19, 2021

2:00 PM

Hoogendoorn Construction Office via Sealed Envelope or electronically (see Invitation to Bid

for further details)

Scope of this Addendum:

To all bidders and all others to whom drawings and specifications have been issued by Architecture Incorporated, this Addendum forms a part of the Contract Documents. Acknowledge receipt of this addendum by listing its number and date in the bidder's Form of Proposal. Failure to do so may subject bidder to disqualification. This addendum modifies the drawings and specifications as follows:

GENERAL ITEMS:

1) SPECIFICATION SECTION – 072726 FLUID-APPLIED WEATHER BARRIERS

a) CLARIFICATION: Provide fluid-applied weather barrier at all locations noted 'BUILDING WRAP'.

2) SPECIFICATION SECTION – 095426 SUSPENDED WOOD CEILINGS

- a) PART 2, 2.2 A; Provide the following in lieu of specification, omit custom sizing:
 - i) Woodworks Grille Item number 7094BO:
 - (1) slat width 1"
 - (2) slat height 2-1/4"
 - (3) 4-slats per panel
 - (4) slat spacing edge to edge 2"
 - (5) overall height including the slat height and backer thickness 2-3/4"

3) SPECIFICATION SECTION – 108213 ROOFTOP EQUIPMENT SCREENS

- a) Provide rooftop equipment screens as specified at locations noted 'Mechanical Screen' on exterior elevations.
 - i) Verify final equipment sizing and clearance requirements with mechanical contractor.

4) DRAWING 4.10 – FIRST FLOOR PLAN

- a) At WORKROOM 103 Casework on demising wall between RECEPTION 102 and WORKROOM 103, verify clearnaces required for electrical panel B ahead of casework installation adjust to the northeast as required for clearance.
- b) Borrow lite locations (See SHEET 5.11 ALUMINUM FRAME ELEVATIONS for dimensions):
 - i) Borrowed Lite Type 1: 171 ADMIN (qty. 1)
 - ii) Borrowed Lite Type 2: 136 CONF (qty. 1)

5) <u>DRAWING 5.10 – EXTERIOR ELEVATIONS</u>

- a) Reference revised exterior elevations for ACM Wall Panel joint locations.
- b) Reference Specification Section 108213 Rooftop Equipment Screens for locations noted 'Mechanical Screen' on elevations.

6) DRAWING 5.40 / 5.41 – SECTION DETAILS

- a) Provide 1 ½" continuous rigid insulation on the outside of the glass mat gypsum sheathing at the high roof overhang condition show in details 1/5.40, 1/5.41 & 4/5.41.
 - i) Provide z-furring as necessary for installation of ACM wall / soffit panels.

7) <u>DRAWING 6.10 – REFLECTED CEILING PANEL</u>

- a) CLARIFICATION: ACM Wall Panels will be installed at horizontal soffits in the following locations.
 - i) Entrance canopy location noted 'ACM PANEL SOFFIT' on reflected ceiling plan.
 - ii) High roof overhangs as noted 'Prefinished metal-faced composite wall panel' on details 1/5.40, 1 & 4/5.41.
 - iii) Head of window condition as noted 'Prefinished metal-faced composite wall panel' on detail 2/5.41.

GENERAL ARCHITECTURAL APPROVALS:

The following material or equipment furnished by the manufacturers listed, may be substituted as equivalent providing that each item, material, and piece of equipment conforms to the design and requirement of the specifications.

SECTION	ITEM	<u>MANUFACTURER</u>
042000	Unit Masonry Assemblies - Flexible Flashing	York – York 304
083613	Sectional Overhead Doors	Midland Garage Door MFG CO

MECHANICAL DRAWING ITEMS:

Refer to attached drawings, dated August 16, 2021, for further information regarding changes, unless noted otherwise.

1) DRAWING 8.10 – LEGENDS & DETAILS

a) Revise ADA FIXED & SLIDING SHOWER HEAD DETAIL.

2) DRAWING 8.11 – SCHEDULES & DETAILS

- a) VAV TERMINAL SCHEDULE Remove VAV-106 from schedule.
- b) FAN POWERED VAV TERMINAL SCHEDULE Add FP-106 to schedule.

3) DRAWING 8.20 – UNDERGROUND PLAN – PLUMBING

- a) Revise W & DS routing in several locations to provide increased clearance from nearby parallel footings.
- b) Revise keynotes for domestic water and fire protection piping coming into the building to emphasize the extensive coordination required between the plumber and site utility contractor regarding connection location, extent of work by each party, etc.

4) DRAWING 8.21 – FIRST FLOOR PLAN – PLUMBING & HEATING

- a) Revise the location of the CW & HW piping for SH-1 in "Shower 163".
- b) Remove RCP's in "Conf 106". Revise piping connections to accommodate new FP-106.

5) DRAWING 8.30 – FIRST FLOOR PLAN – VENTILATION & A/C

a) Change VAV-106 to FP-106. Provide (3) G7 linear slot diffusers in lieu of D3 diffusers.

SUBSTITUTIONS AND PRODUCT OPTIONS

The following material or equipment furnished by the manufacturers listed may be substituted as equal, providing that each item, material and piece of equipment conforms to the design and requirements of the Drawings and Project Manual.

SECTION	ITEM	MANUFACTURER
220400	Water Heaters	Bradford White
		Camus
220600	Cabinet Unit Heaters	Turbonics
220600	Hot Water Radiant Ceiling Panels	Price
220600	Pumps	Pentair Aurora

ELECTRICAL DRAWING ITEMS:

1) <u>DRAWING 9.10 – SITE PLAN – ELECTRICAL</u>

a) See attached updated electrical site plan background drawing. No changes electrically.

2) DRAWING 9.20 – FLOOR PLAN – LIGHTING

a) In reference to Lobby 101, lighting fixtures shall be compatible with the Armstrong Wood Works Grille ceiling system.

3) DRAWING 9.21/9.32 – FLOOR PLAN – POWER & SIGNAL & SCHEDULES


a) In reference to Conference Room 106, add electrical connections for added fan-powered VAV FP-16, 1/2HP, 120V, fed from 20A/1P circuit breaker in Panel B. Provide local disconnecting means, control by mechanical contractor.

SUBSTITUTIONS AND PRODUCT OPTIONS - ELECTRICAL

The following material or equipment furnished by the manufacturers listed may be substituted as equal, providing that each item, material and piece of equipment conforms to the design and requirements of the Drawings and Project Manual.

SECTION	ITEM	MANUFACTURER
265119	LED Lighting	
	Type C/CE/C1	Gotham
	Type G	NovaFlex
	Type Y	Camman
	Type F/FE	Pinnacle

END OF ADDENDUM

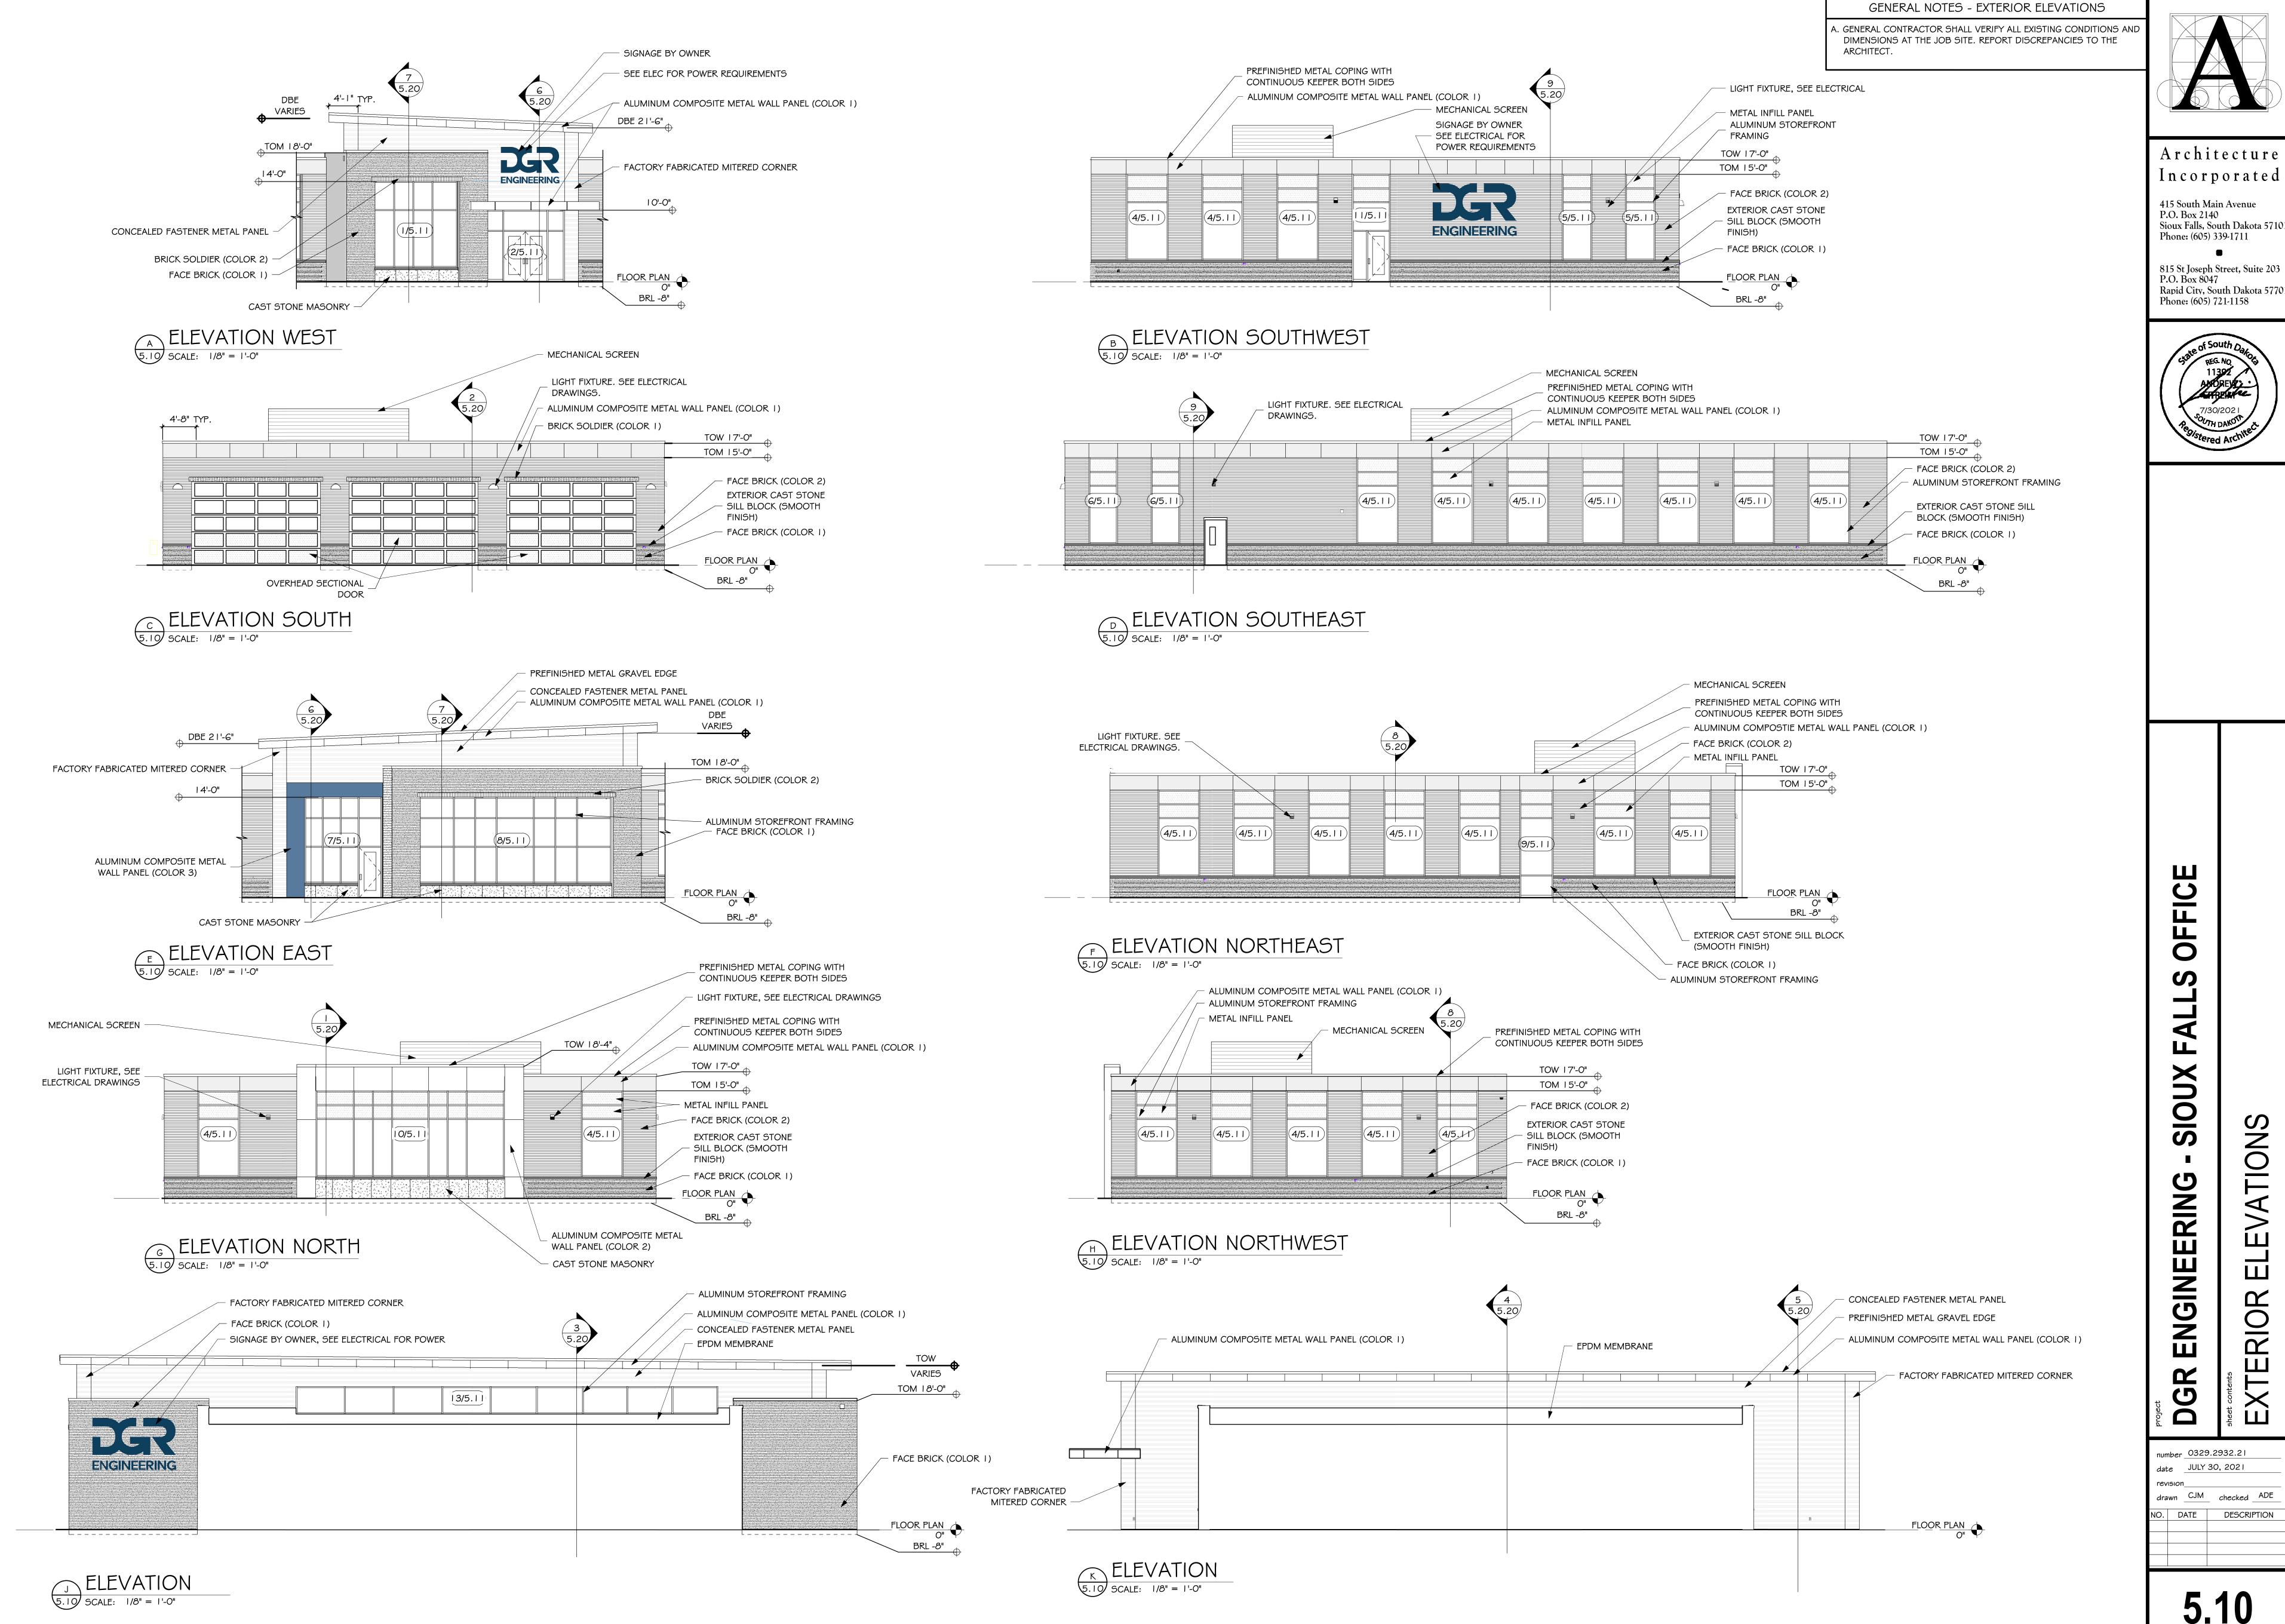



Architecture

Rapid City, South Dakota 57701



drawn CJM checked ADE DESCRIPTION

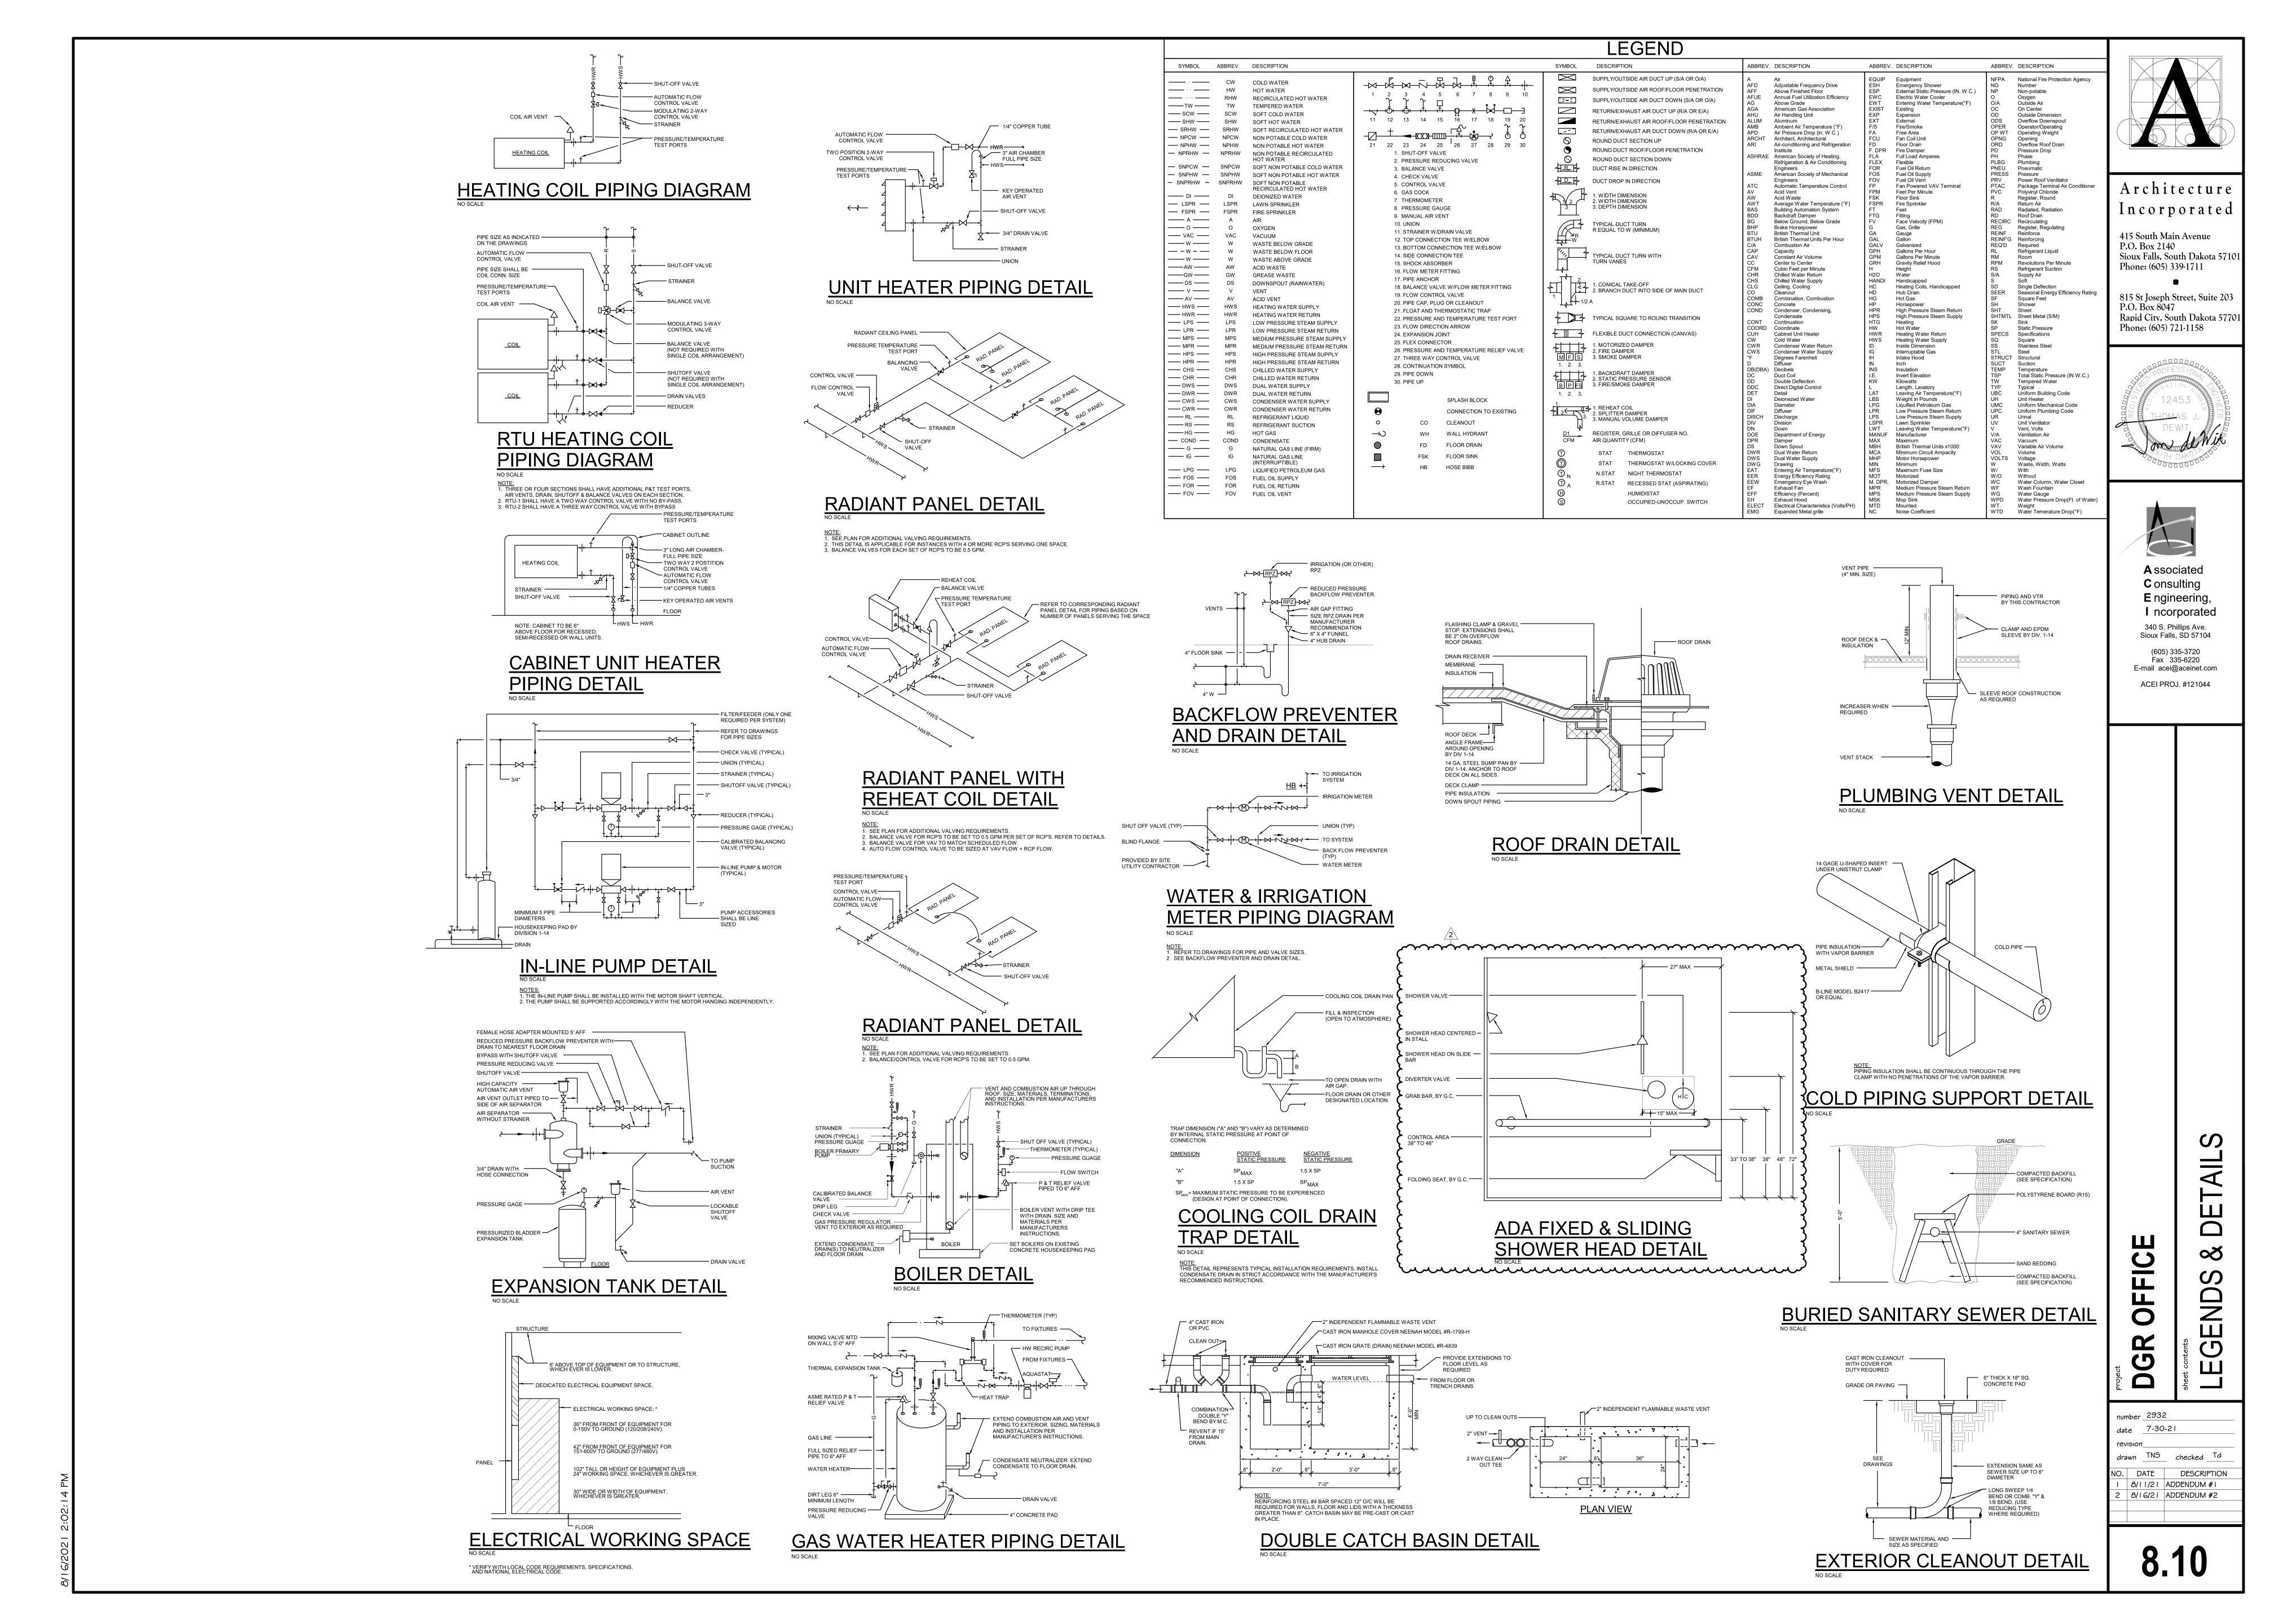

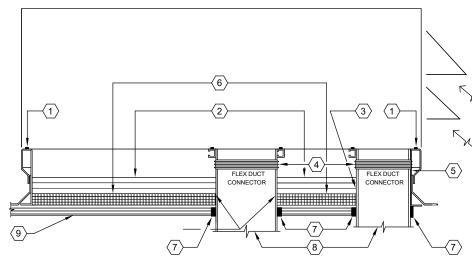


DETAIL NOTES: 1)INSTALL (2) 1/4"X1-1/2" NEOPREME GASKET ALL AROUND CURB PERIMETER AND CROSS MEMBERS. (2) 3 LAYERS OF 1" 3 LB. DENSITY DUCT LINER BOARD BY DIV. 15 OR 23 CONTRACTOR.


3 SEAL AIR TIGHT BETWEEN GYP BOARD AND INSIDE OF CURB. TYPICAL ALL SIDES AND ALL LAYERS. $\langle 4 \rangle$ FLEX DUCT CONNECTOR. 5 ROOF CURB INSTALLED LEVEL.

3 LAYERS OF 5/8" GYP BOARD BY DIV. 15 OR 23 CONTRACTOR. $\langle r \rangle$ SEAL SPACES BETWEEN ROOF DECK AND DUCTS AIRTIGHT. angle THE SUPPLY AND RETURN DUCTWORK SHALL BE 18 GA SHEET METAL, LINED WITH 1" ACOUSTIC LINING (1-1/2 LB/CU.FT.)
SUPPORT FROM STRUCTURE.


RTU SOUND ISOLATION DETAIL

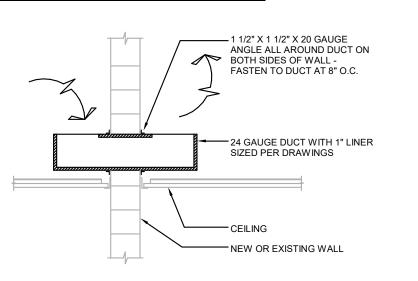


TRANSFER DUCT DETAIL NO SCALE

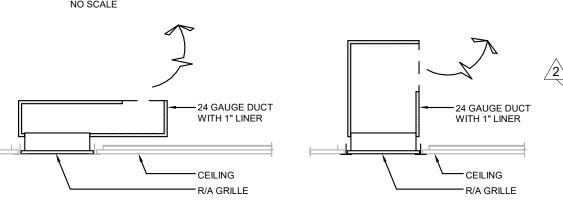


RETURN BOOT DETAIL

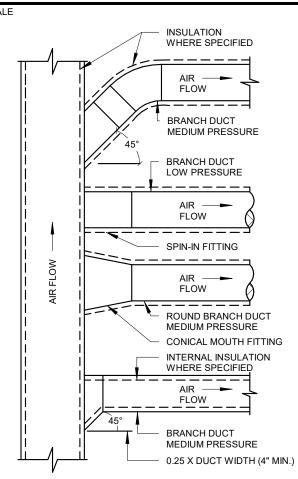


DUCT TAKE-OFF & CONNECTION NO SCALE

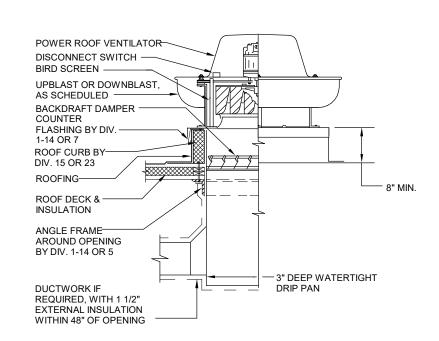

POWER ROOF VENTILATOR DETAIL

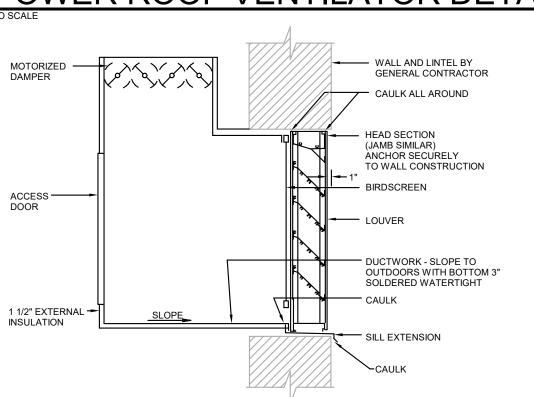

INTAKE AIR LOUVER DETAIL

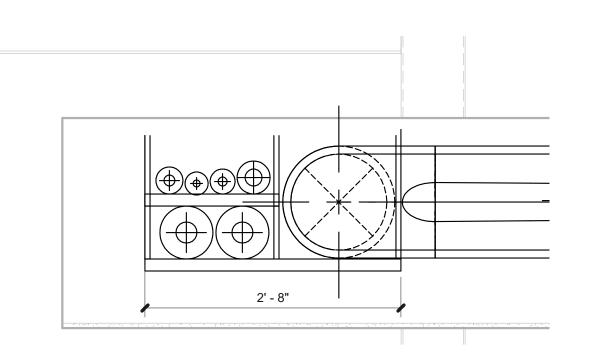

SOFFIT DUCTWORK & PIPING DETAIL
NO SCALE

ROOFTOP UNIT SCHEDULE

U	NIT			SUPPLY FAI	N			EXHAUS	T FAN			HEATI	NG COIL CAP	ACITY							COOL	ING COIL						AMB.	ELEC				FILTER				OPER.	
N	Ο.	MANUF.	MODEL NO.	CFM ESP	TSP	MHP	BHP	CFM E	SP T	TSP M	IHP BHP	MBH	EAT	LAT	FV	APD	EWT	LWT	GPM	WPD	MBH	EAT	LAT	FV	APD E	EER	IEER	TEMP	VOLTS	PH	MCA	MOCP	TYPE	MAX FV	APD	THICK	WT(LBS)	REMARKS
R	TU-1	AAON	RN-020-8-0-KB09-EJL	8000 2.5	4.66	15	8.62	8000 0	0.5 1	1.28 7	.5 5.51	258	58.8/55.9	89.6/66.2	1099.7	7	180	150	17	5	222	77.5/63.84	54.07/53.83	402.8	1	13.2	21.5	95	208	3	148	175	MERV 13	350		2"	3100	1,2,3,4,5,6,7,8
R	TU-2	AAON	RN-020-8-0-KB09-EJL	8000 2.5	4.66	15	8.62	8000 0).5 1	1.28 7	.5 5.51	258	58.8/55.9	89.6/66.2	1099.7	7	180	150	17	5	222	77.5/63.84	54.07/53.83	402.8	1	13.2	21.5	95	208	3	148	175	MERV 13	350		2"	3100	1,2,3,4,5,6,7,8

1. HEATING AND COOLING CAPACITIES ARE BASED ON 75% WATER/ 25% PROPYLENE GLYCOL.

- ESP INCLUDES AN ALLOWANCE 0.5" FOR DIRTY FILTERS. PROVIDE SINGLE POINT POWER CONNECTION AND ELECTRICAL DISCONNECT. COORDINATE SCCR RATING WITH ELECTRICAL CONTRACTOR.
- PROVIDE 100% ECONOMIZER WITH MODULATING POWERED EXHAUST. 5. PROVIDE 2 SCROLL COMPRESSORS WITH ONE COMPRESSOR BEING A VARIABLE SPEED SCROLL COMPRESSOR.
- 6. FANS CONTROLLED BY VFD. 7. PROVIDE CONVENIENCE OUTLET WIRED SEPARATELY FROM THE UNIT. 8. PROVIDE STAINLESS STEEL DRAIN PAN.

FAN POWERED VAV TERMINAL SCHEDULE

	UNIT	MANUF.	MODEL	INLET	CFM	MIN	TERM.	EXT	RAD	DISCH	MOTOR	МОТО	₹		HEATIN	NG COIL	-				REMARKS	
,	1	~~~	Wo.	SZE	\sim	eru-	\$.P~	\$# \ ~	V6~	We ~		VOLI.	₩\	-MOCE		WBH.	SPM	-WPD-	EMT~	₩ T	$\sim\sim$	~
ξ.	FP-106	PRICE	FDV	10	900	340	0.25"	0.5"	29	26	1/2	120	1	15	64	28.8	2.0	5	180	150	1,2,3,4,5,6	
	FP-140A	PRICE	FDV	12	1400	420	0.25"	0.5"	33	34	1/2	120		15	64	30.1	2.1	5	180	150	1,2,3,4,5,6	J
	FP-140B	PRICE	FDV	12	1400	420	0.25"	0.5"	33	34	1/2	120	1	15	64	30.1	2.1	5	180	150	1,2,3,4,5,6	
	FP-150	PRICE	FDV	12	1200	360	0.25"	0.5"	33	34	1/2	120	1	15	64	30.5	2.1	5	180	150	1,2,3,4,5,6	

- 1. SOUND DATA SHALL BE TAKEN FROM ARI STANDARDS 880 (LATEST PUBLISHED DATA @ 1.5" DELTA P.)
- 2. NC RATING INCLUDE A RETURN INLET ATTENUATOR. PROVIDE RETURN INLET ATTENUATOR. 3. EXT. S.P. INCLUDES A COIL APD.
- 4. COIL CAPACITIES ARE BASED ON 75% WATER/25% PROPYLENE GLYCOL.
- 5. PROVIDE ECM MOTOR. ELECTRICAL DISCONNECT BY ELECTRICAL CONTRACTOR. 6. SIZE FAN FOR 70% OF THE MAX CFM.

VAV TERMINAL SCHEDULE

UNIT	MANUF.	MODEL NO.	INLET	CLG CFM	CLG CFM	HTG CFM	TERM	RAD	DISCH	HEATI	NG COIL	=				REMARKS
NO.			SIZE	MAX	MIN	MAX	S.P.	NC	NC	EAT	MBH	GPM	WPD	EWT	LWT	
VAV-101	PRICE	SDV	6	300	90	130	0.5"	20	21	55	8.9	0.6	5	180	150	1,2,3
A COPY COPY COPY COPY COPY COPY COPY COPY	PRICE	~8B/~~	~~~	~~~~	~~~	~~~~	P5"~	20~	2 / ~	755~	30m	♣ ~	ب ہ	1887	450~	123m
mm	m	سسلر	ىرىل	سس	بريبريبر	سا	Lu.	L.	سر	Lu.	س	ىرىر	ب	w	m.	mm
VAV-109	PRICE	SDV	12	1255	380	380	0.5"	25	26	55	16.9	1.2	5	180	150	1,2,3
VAV-112	PRICE	SDV	8	390	120	130	0.5"	24	25	55	8.9	0.6	5	180	150	1,2,3
VAV-114	PRICE	SDV	8	470	150	180	0.5"	24	25	55	12.5	0.9	5	180	150	1,2,3
VAV-116	PRICE	SDV	6	335	110	130	0.5"	20	21	55	8.9	0.6	5	180	150	1,2,3
VAV-119	PRICE	SDV	12	1215	370	370	0.5"	25	26	55	16.6	1.1	5	180	150	1,2,3
VAV-122	PRICE	SDV	10	900	270	270	0.5"	23	24	55	13.2	0.9	5	180	150	1,2,3
VAV-128	PRICE	SDV	8	525	160	160	0.5"	24	25	55	4.9	0.5	5	180	150	1,2,3
VAV-129	PRICE	SDV	6	205	70	70	0.5"	20	21	55	2.5	0.5	5	180	150	1,2,3
VAV-133	PRICE	SDV	6	250	80		0.5"	20	21	55						4
VAV-135	PRICE	SDV	6	230	70	70	0.5"	20	21	55	2.5	0.5	5	180	150	1,2,3
VAV-136	PRICE	SDV	6	285	30	30	0.5"	20	21	55	2.3	0.5	5	180	150	1,2,3
VAV-139A	PRICE	SDV	10	800	240	240	0.5"	23	24	55	15.7	1.1	5	180	150	1,2,3
VAV-139B	PRICE	SDV	10	800	240	240	0.5"	23	24	55	16.0	1.1	5	180	150	1,2,3
VAV-151	PRICE	SDV	10	850	260	260	0.5"	23	24	55	7.4	0.5	5	180	150	1,2,3
VAV-153	PRICE	SDV	12	1240	380	380	0.5"	25	26	55	16.8	1.2	5	180	150	1,2,3
VAV-157	PRICE	SDV	10	930	280	280	0.5"	23	24	55	12.1	0.8	5	180	150	1,2,3
VAV-169	PRICE	SDV	6	300	90	90	0.5"	20	21	55	5.9	0.5	5	180	150	1,2,3
VAV-171	PRICE	SDV	8	395	120	120	0.5"	24	25	55	7.3	0.5	5	180	150	1,2,3
VAV-180	PRICE	SDV	6	220	70	70	0.5"	20	21	55	1.7	0.5	5	180	150	1,2,3
VAV-182	PRICE	SDV	6	250	80		0.5"	20	21	55						4

REMARKS: 1. SOUND DATA SHALL BE TAKEN FROM ARI STANDARDS 880 (LATEST PUBLISHED DATA @ 1.5" DELTA P.)

- 2. EXT. S.P. INCLUDES A COIL APD.
- 3. COIL CAPACITIES ARE BASED ON 75% WATER/25% PROPYLENE GLYCOL.
- COOLING ONLY VAV.

FAN SCHEDULE

FAN	MANUF.	MODEL NO.	TYPE	CFM	S.P.	RPM	TIP	мотс	R	ELEC.		SONES	OPER. WT.	REMARKS
NO.							SPEED	HP	BHP	VOLTS	PH		(LBS)	
EF-1	GREENHECK	G-095-VG	PRV	475	0.3	1466		1/6	0.09	115	1	8.5	30	1,2
EF-2	GREENHECK	G-080-VG	PRV	250	0.35	1459		1/10	0.04	115	1	6.8	30	1,2
EF-3	GREENHECK	G-140-VG	PRV	1890	0.3	1160		1/2	0.31	115	1	10.6	60	1,2
EF-4	GREENHECK	G-097-VG	PRV	135	0.3	1041		1/4	0.03	115	1	4.1	40	1,2

1. PROVIDE ECM MOTOR, FAN SPEED CONTROLLER, INTEGRAL ELECTRICAL DISCONNECT. 2. PROVIDE INSULATED ROOF CURB AND BACKDRAFT DAMPER.

REGISTER GRILLE & DIFFUSER SCHEDULE

SYMBOL	MANUF.	CONSTR	MODEL	MAX	OVERALL	THROAT	NC	THROW	TOTAL PD	FRAME	PATTERNS	REMARKS
		MAT"L	NO.	CFM	SIZE	SIZE			(IN.W.G.)			
D1	KRUEGER	S	PLQ	270	24/24	8"ø	16	11	0.07	LAY-IN/SURFACE	4-WAY	
D2	KRUEGER	S	PLQ	380	24/24	10"ø	15	13	0.08	LAY-IN/SURFACE	4-WAY	
D3	KRUEGER	S	1400	575	24/24	12"ø	30	20	0.10	LAY-IN	4-WAY	
G1	KRUEGER	Α	EGC5	1000	24/12	22/10	25		0.08	LAY-IN/SURFACE	1/2" GRID	
G2	KRUEGER	Α	EGC5	1400	24/24	22/22	15		0.03	LAY-IN/SURFACE	1/2" GRID	
G3	KRUEGER	Α	EGC5	250	12/12	10/10			0.03	SURFACE	1/2" GRID	
G4	KRUEGER	Α	5885	270	16/8	14/6	17	30	0.05	SURFACE	DD	1
G5	KRUEGER	Α	EGC5	2800	36/24	34/22	19		0.05	SURFACE	1/2" GRID	
G6	KRUEGER	S	PTBA-1"	200	48/6		23	14	0.07	LAY-IN	2-WAY	3
G7	KRUEGER	S	PTBA-1"	450	48/8		31	35	0.09	LAY-IN	1-WAY	4
G8	KRUEGER	Α	5885	150	12/8	10/6		23	0.03	SURFACE	DD	1,2
G9	KRUEGER	Α	EGC5	1400	48/10	46/8	18		0.056	SURFACE	1/2" GRID	1

LEGEND: R - REGISTER SD - SINGLE DEFLECTION

G - GRILLE D - DIFFUSER

DD - DOUBLE DEFLECTION

A - ALUMINUM CONSTRUCTION. S - STEEL CONSTRUCTION.

GENERAL NOTES:

THROWS ARE BASED ON TERMINAL VELOCITIES AT 50 FPM. NC VALUES ARE BASED UPON A 10dB ROOM ATTENUATION. SEE SPECIFICATIONS FOR OPPOSED BLADE DAMPER REQUIREMENTS.

COLOR BY ARCHITECT.

PROVIDE WITH ANODIZED FINISH.

PROVIDE (3) 1" SLOTS WITH 2-WAY OPPOSITE THROW. COORDINATE FRAME TYPE WITH ARCHITECTURAL CEILING PLANS. 4. PROVIDE (4) 1" SLOTS WITH 1-WAY HORIZONTAL THROW TOWARDS EXTERIOR WINDOWS. COORDINATE FRAME TYPE WITH ARCHITECTURAL CEILING PLANS.

LOUVER SCHEDULE

LVR	MANUF.	MODEL NO.	SIZE	FREE AREA	CFM	VEL FPM	PD IN. WG	REMARKS
NO.			WXHXD	S.F.				
LVR-1	GREENHECK	ESD-635	48 X 27 X 6	4.5	2025	452	0.03	1
	•	•				•		

COLOR BY ARCHITECT.

WATER HEATER SCHEDULE

	UNIT	MANUF.	MODEL NO.	TANK	INPUT	EFF.	RECOVERY @	ELECTRICAL		REMARKS
)	NO.			(GALLONS)	(MBH)		95° GPH	VOLTS	PH	
	WHTR-1	AO SMITH	BTH-120	60	120	95%	145	120	1	ALL

- ASME T&P RELIEF VALVE.
- 2. PROVIDE WITH AMTROL ST-5 EXPANSION TANK, OR EQUAL.
- 3. DIRECT VENT/SEALED COMBUSTION. PROVIDE WITH CONCENTRIC VENT KIT. SIZE AND INSTALL PER MANUFACTURER'S RECOMMENDATIONS.
- 4. PROVIDE CONDENSATE NEUTRALIZATION KIT.

5. PROVIDE CORD & PLUG.

W	'ATE	R SOFT	ENER S	CHED	JLE						
UNIT		MANUF.	MODEL NO.	PEAK FLOW		CONT. FLOW	I	RESIN SIZE	ELECTRICA	L	REMARKS
NO.				GPM	PSI DROP	GPM	PSI DROP	(CU. FT.)	VOLTS	PH	
W/S-1		CHLUGAN	CTM-90	75	25	57	15	3	120	1	ΔΙΙ

- 1. SIMPLEX WATER SOFTENER CONFIGURATION WITH BRINE TANK.
- 2. UNIT SHALL BE CAPABLE OF MEASURING 1.0 GPM MINIMUM FLOW.
- 3. UNIT SHALL BE CAPABLE OF METERING REGENERATION CONTROL. 4. INSTALL WITH ALL MANUFACTURERS RECOMMENDED VALVES, ACCESSORIES, AND INTERCONNECTING PIPING REQUIRED TO MAKE A COMPLETE SYSTEM.

5. INSTALL ON 4" CONCRETE PAD. PAD BY THE GENERAL CONTRACTOR.

BOIL	ER SCHEDU	JLE								
UNIT	MANUF.	MODEL	AGA INPUT	AGA OUTPUT	OPER	BURNER			OPER. WT	REMARKS
NO.		NO.	(MBH)	(MBH)	EFF. (%)	VOLT	PH	AMPS	(LBS)	
B-1	THERMAL SOLUTIONS	EVS-500	500	431	87	120	1	4.5	900	ALL
B-2	THERMAL SOLUTIONS	EVS-500	500	431	87	120	1	4.5	900	ALL

REMARKS:

1. PROVIDE CONDENSATE NEUTRALIZER. 2. PROVIDE EMERGENCY SHUT-OFF MUSHROOM SWITCH.

3. PROVIDE WITH VENT AND COMBUSTION AIR PIPING UP THROUGH ROOF. SIZE, MATERIALS, TERMINATIONS, AND INSTALLATION PER MANUFACTURER'S INSTRUCTIONS.

UNIT	MANUF.	MODEL	DESCRIPTION	STYLE	SIZE	GPM	HEAD	мото)R		ELEC		SUCTION	DISCH	REMARKS
NO.		NO.					(FT)	MHP	BHP	RPM	VOLTS	PH	SIZE	SIZE	
P-1	B&G	PL-55	PRIMARY HEATING	INLINE		30	20	2/5		3450	115	1	1 1/2"	1 1/2"	1,2
P-2	B&G	PL-55	PRIMARY HEATING	INLINE		30	20	2/5		3450	115	1	1 1/2"	1 1/2"	1,2
P-3	B&G	E-90	SECONDARY HEATING	INLINE	1.25AAB	48	65	2	1.2	3475	208	3	1 1/4"	1 1/4"	1,3,4
P-4	B&G	E-90	SECONDARY HEATING	INLINE	1.25AAB	48	65	2	1.2	3475	208	3	1 1/4"	1 1/4"	1,3,4
P-5	B&G	PL-30	HW RECIRC.	INLINE		10	15	1/12		2650	115	1	3/4"	3/4"	2

- 1. PUMP CAPACITY BASED UPON 75% WATER/25% PROPYLENE GLYCOL.
- BRONZE BODY
- 3. PUMP SHALL BE NON-OVERLOADING. 4. PUMP SHALL HAVE VFD.

UNIT HEATER SCHEDULE

UNIT	MANUF.	UNIT	TYPE	INTAKE	DISCHARGE	CFM	FAN MOTOR(S)				HEATIN	REMARKS					
NO.		SIZE		LOCATION	LOCATION		RPM	FAN HP-1	FAN HP-2	VOLT	PH	MBH	EWT	LWT	GPM	WPD	
CUH-100	BEACON/MORRIS	04	SRWI	FT	FB	430	1050	1/10		115	1	22	180	150	1.8	5'	1,2
CUH-168	BEACON/MORRIS	03	SRWI	FT	FB	335	1050	1/15		115	1	17	180	150	1.3	5'	1,2
UH-181A	BEACON/MORRIS	HB-96				1400	1000	1/12		115	1	52	180	150	4.1	5'	1,3
UH-181B	BEACON/MORRIS	HB-96				1400	1000	1/12		115	1	52	180	150	4.1	5'	1,3

MODEL TYPE: F - FLOOR; FI - FLOOR INVERTED FLOW; W - WALL; WI - WALL INVERTED FLOW; FRW - FULLY RECESSED WALL FRWI - FULLY RECESSED WALL INVERTED FLOW; SRW - SEMI RECESSED WALL; SRWI - SEMI RECESSED WALL INVERTED FLOW

C - CEILING; RC - RECESSED CEILING; HP - HORIZONTAL PROPELLER UNIT

LOCATIONS: F - FRONT; R - REAR; B - BOTTOM; T - TOP

1. HEATING CAPACITIES ARE BASED ON 75% WATER/25% PROPYLENE GLYCOL 2. PROVIDE TAMPER RESISTANT FASTENERS FOR ACCESS DOORS

3. HANG UNIT FROM STRUCTURE WITH NEOPRENE ISOLATORS.

PLUI	MBING FIXTURE	SCHE	DULE							
FIXTURE SYMBOL	DESCRIPTION	MANUF.	MODEL NO.	TRIM	SUPPLIES	WASTE	REMARKS			
WC-1	WATER CLOSET, FLUSH VALVE, WALL HUNG, ELONG, ADA	AMERICAN STANDARD	2634.101	SLOAN 152- ESS-1.6-TMO			CHURCH 9500SSCT SEAT, JOSAM SERIES 12000 CARRIER, REFER TO ARCH PLANS FOR MOUNTING HEIGHT, BACK SPUD, TRUE MECHANICAL OVERRIDE, HARDWIRED			
L-1	LAVATORY, UNDERCOUNTER, ADA	KOHLER K-8189-0		SLOAN EFX-250-BAT-ISM (NICKEL FINISH)	BRASSCRAFT KTSCR19C	GRID DRAIN	17 GA C.P. P-TRAP, TRUEBRO WASTE & WATER PIPE PROTECTOR, OFFSET WASTE ARM, BATTERY OPERATOR CONFIRM FINISHES WITH ARCHITECT PRIOR TO ORDER, TRIM APPEARANCE TO MATCH CORRESPONDING SOAP DISPENSER (BY G.C.), TEMPERATURE MIXER CONTROL			
MSK-1	MOP SINK, FLOOR MOUNTED	ZURN Z1996-24-SD-HH-N		Z843M1-RC-CS W/ VACUUM BREAKER			CW HB MTD 5'-0" AFF, DOME STRAINER, HOSE & BRACKET, MOP BRACKET, CHECK STOPS AT FAUCET HANDLES			
SK-1	SINK, QUARTZ, UNDERMOUNT, DOUBLE COMPARTMENT	ELKAY	ELGDULB3322 (BLACK FINISH)	KOHLER K-596 KITCHEN FAUCET, KOHLER K-6665-AG WATER FILL FAUCET (BLACK FINISHES)	BRASSCRAFT KTSCR19C	LK-35 STRAINER, LK-53 CONT WASTE	17 GA C.P. P-TRAP, GOOSENECK FAUCET, PULL-DOWN SPRAY WAND, CERAMIC DISK CARTRIDGES, IN-SINK-ERATOR BADGER 5 DISPOSAL, CONFIRM FINISHES WITH ARCHITECT PRIOR TO ORDER			
SK-2	UTILITY SINK WALL MOUNTED	FIAT	L-1	CHICAGO 895-317XKABCP	BRASSCRAFT KTSCR19C	STRAINER,	17 GA C.P. P-TRAP, WRIST BLADE HANDLES, GOOSENECK SPOUT, CERAMIC DISK CARTRIDGES			
SH-1	SHOWER, ADA	BESTBATH	P26333A75T.V2 (FINISH BY ARCH)	AMERICAN STANDARD T064.740 TRIM KIT, 9135073 FIXED HEAD, 9035.154 HAND SHOWER (NICKEL FINISHES)		2" FLOOR DRAIN	SLIDING & FIXED SHOWER HEADS W/ 2-WAY DIVERTER. FLEXIBLE DAM AND REMOVABLE THRESHOLD. PROVIDE W/ METAL HOSE, VACUUM BREAKER, WALL SUPPLY, AND SHOWER ARMS. TILE SURROUND, GRAB BARS, AND FOLDUP SEAT BY G.C. CONFIRM COLOR/FINISHES W/ ARCHITECT.			
UB-1	ICE MAKER UTILITY BOX	SIOUX CHIEF	696-G1010MF				FIELD COORDINATE MOUNTING HEIGHT, SHOCK ABSORBER, SHUT-OFF VALVE			
				1	1	1				

25 GPM AT 10 PSI DROP

1. HANDICAPPED FLUSH VALVES SHALL BE ADA COMPLIANT.

THERMOSTATIC

MIXING VALVE

2. FLUSH VALVES SHALL HAVE A VANDAL RESISTANT STOP CAP.

LAWLER

3. FLUSH VALVE ESCUTCHEONS SHALL BE CHROME PLATED WITH HEAVY WALL THICKNESS AND SET SCREW. 4. PROVIDE & INSTALL (1) SLOAN PLUG-IN TRANSFORMER MODEL EL-154 PER 8 HARDWIRED FIXTURES IN PLUMBING CHASE.

PROVIDE & INSTALL INTERCONNECTING LOW VOLTAGE WIRING AND CONNECTIONS TO SENSORS.


Architecture Incorporated

415 South Main Avenue P.O. Box 2140

Sioux Falls, South Dakota 57101

Phone: (605) 339-1711

815 St Joseph Street, Suite 203 P.O. Box 8047 Rapid City, South Dakota 57701 Phone: (605) 721-1158

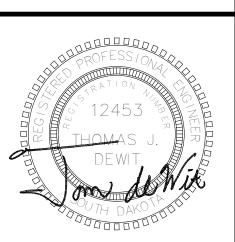




A ssociated **C** onsulting Engineering, I ncorporated 340 S. Phillips Ave. Sioux Falls, SD 57104

(605) 335-3720 Fax 335-6220 E-mail acei@aceinet.com ACEI PROJ. #121044

number _2932 date <u>7-30-21</u> revision_ drawn DK/TS checked Td . DATE DESCRIPTION 8/11/21 ADDENDUM #1

2 8/16/21 ADDENDUM #2

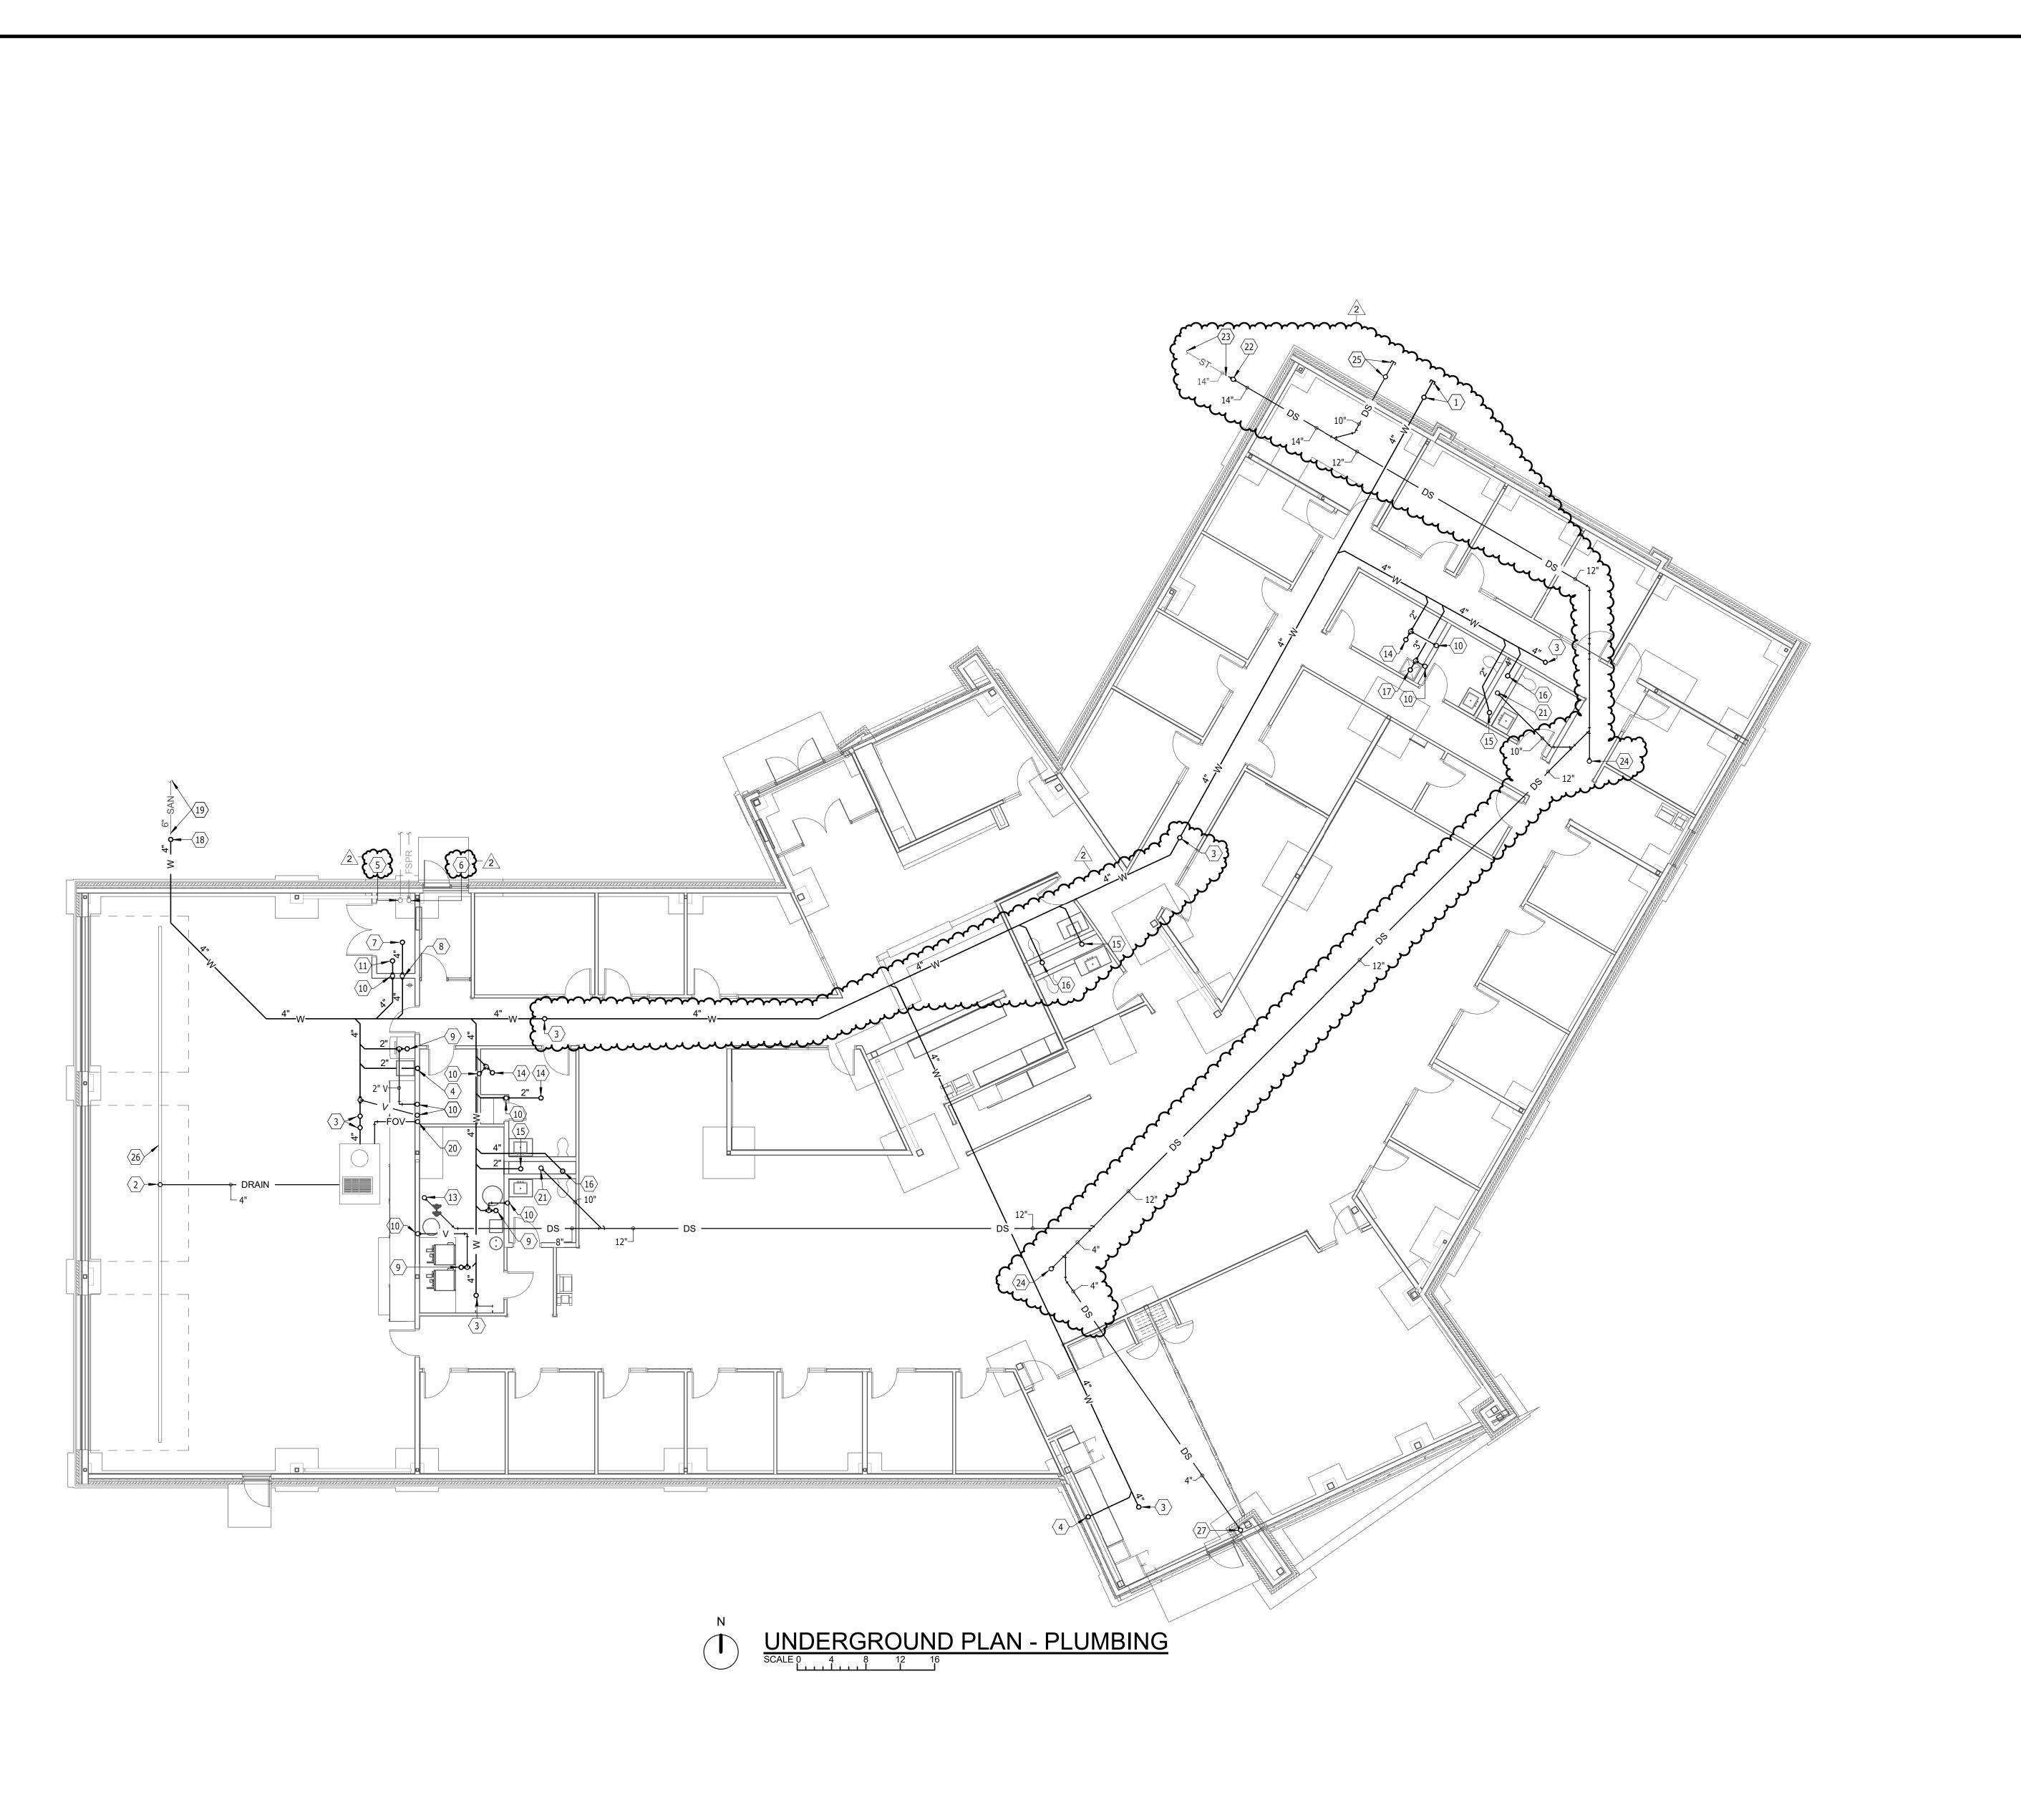


GENERAL SHEET NOTES

- THE CEILING SPACE AVAILABLE REQUIRES COORDINATION WITH OTHER TRADES. THE CONTRACTORS SHALL PROVIDE ALL OFFSETS AND RELOCATE AS REQUIRED TO COORDINATE THE INSTALLATION OF ALL MATERIALS AND EQUIPMENT WITH OTHER TRADES.
- ON DEMO DRAWINGS, ITEMS SHOWN LIGHT ARE EXISTING TO REMAIN, ITEMS SHOWN BOLD ARE EXISTING TO BE REMOVED. ON NEW CONSTRUCTION DRAWINGS, ITEMS SHOWN LIGHT ARE EXISTING T REMAIN, ITEMS SHOWN BOLD ARE NEW WORK.

PLUMBING NOTES


- 4" W UP TO GRADE CO. CAP & INSTALL WITH INVERT AT A MINIMUM 24" BELOW GRADE TO ACCOMMODATE POTENTIAL FUTURE EXPANSION. INSULATE SHALLOW EXTERIOR WASTE PIPING PER DETAIL.
- 4" DRAIN UP TO TD.
- 3 4" W UP TO CO. 2" W UP TO SK.
- WATER SERVICE STUBBED TO BLIND FLANGE BY SITE UTILITY CONTRACTOR. SEE SITE UTILITY PLANS FOR CONTINUATION AND FURTHER DETAILS. COORDINATE WITH SITE UTILITY CONTRACTOR REGARDING EXACT
- CONNECTION LOCATION, EXTENT OF WORK, ETC. PRIOR TO WORK. FIRE PROTECTION SERVICE STUBBED TO BLIND FLANGE BY SITE UTILITY CONTRACTOR. SEE SITE UTILITY PLANS FOR CONTINUATION AND FURTHER DETAILS. COORDINATE WITH SITE UTILITY CONTRACTOR REGARDING EXACT CONNECTION LOCATION, EXTENT OF WORK, ETC. PRIOR TO WORK. 7 4" W UP TO FSK.
- 8 4" V UP. 9 2" W UP TO FSK.
- 10 2" V UP. 11 4" W UP TO HD. 12 12" COMBINED DS/ODS UP.
- 13 8" COMBINED DS/ODS UP.
- 14 2" W UP TO FD. 15 2" W UP TO LAV.
- 16 4" W UP TO WC. 17 3" W UP TO MSK.
- 18 4" W UP TO GRADE CO.
- 19 CONNECT TO PIPING PROVIDED BY SITE UTILITY CONTRACTOR. SEE SITE UTILITY DRAWINGS FOR CONTINUATION. COORDINATE EXACT LOCATION AND INVERTS WITH EXISTING CONDITIONS AND SITE UTILITY CONTRACTOR. INSTALL WITH MINIMUM INVERT 5' BELOW GRADE AS THE PIPE EXITS THE BUILDING FOOTPRINT, AS ABLE. COORDINATE INSULATION REQUIREMENTS FOR ANY SHALLOW EXTERIOR PIPING WITH SITE UTILITY CONTRACTOR.
- 20 2" FOV UP. 21 10" COMBINED DS/ODS UP.
- 22 4" DS UP TO GRADE CO.
- 23 CONNECT TO PIPING PROVIDED BY SITE UTILITY CONTRACTOR. SEE SITE UTILITY DRAWINGS FOR CONTINUATION. COORDINATE EXACT LOCATION AND INVERTS WITH EXISTING CONDITIONS AND SITE UTILITY CONTRACTOR. 24 4" DS UP TO CO.
- 25 4" DS UP TO GRADE CO. CAP 10" DS PIPING AT MAXIMUM DEPTH TO ACCOMMODATE POTENTIAL FUTURE ADDITION. INSULATE ANY SHALLOW EXTERIOR DS PIPING PER DETAIL.
- 26 TRENCH DRAIN. ZURN Z886-GFG WITH GALVANIZED DUCTILE IRON FRAME & SLOTTED GRADE - CLASS F OR EQUAL.
- 27 4" COMBINED DS/ODS UP.

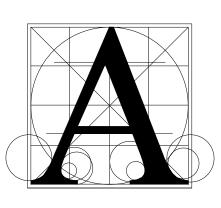

Architecture Incorporated

415 South Main Avenue P.O. Box 2140 Sioux Falls, South Dakota 57101 Phone: (605) 339-1711

815 St Joseph Street, Suite 203 P.O. Box 8047 Rapid City, South Dakota 57701 Phone: (605) 721-1158

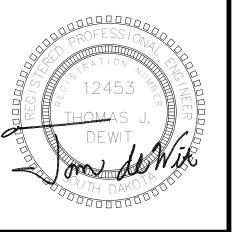



A ssociated **C** onsulting **E** ngineering, I ncorporated 340 S. Phillips Ave. Sioux Falls, SD 57104 (605) 335-3720

Fax 335-6220 E-mail acei@aceinet.com ACEI PROJ. #121044

-UMBING

DG

number _2932

| 8/11/21 | ADDENDUM #1 2 8/16/21 ADDENDUM #2

GENERAL SHEET NOTES

- THE CEILING SPACE AVAILABLE REQUIRES COORDINATION WITH OTHER TRADES. THE CONTRACTORS SHALL PROVIDE ALL OFFSETS AND RELOCATE AS REQUIRED TO COORDINATE THE INSTALLATION OF ALL MATERIALS AND EQUIPMENT WITH OTHER TRADES. ON DEMO DRAWINGS, ITEMS SHOWN LIGHT ARE EXISTING TO SHOWN BOLD ARE EXISTING TO BE REMOVED. ON NEW CONSTRUCTION DRAWINGS, ITEMS SHOWN LIGHT ARE EXISTING
- REMAIN, ITEMS SHOWN BOLD ARE NEW WORK.

PLUMBING & HEATING NOTES

SAND-OIL INTERCEPTOR. SEE DETAIL. 3/4" HW DN, 3/4" RHW DN, 1 1/2" V/2" W DN, 1/2" SCW, 1/2" CW DN TO SK. ROUTE HARD WATER TO WATER FILL FAUCET, ROUTE SOFT WATER TO MAIN SINK FAUCET. PROVIDE 1/2" HW TAP OFF OF RECIRCULATION LOOP DN TO FIXTURE FOR SERVICE TO FIXTURE. PROVIDE FLEXIBLE HW SUPPLY FROM RECIRCULATION LOOP AND DRAIN CONNECTION TO ADJACENT DISHWASHER. COORDINATE EXACT EQUIPMENT SELECTIONS, INSTALLATION REQUIREMENTS ROUGH-IN LOCATIONS, ETC. WITH GENERAL CONTRACTOR AND OWNER-PROVIDED EQUIPMENT PRIOR TO WORK.

1/2" CW DN TO COFFEE MAKER(S). FIELD COORDINATE EXACT NUMBER OF COFFEE MAKERS, EQUIPMENT SÉLECTIONS, INSTALLATION REQUIREMENTS,


- ROUGH-IN LOCATIONS, ETC. PRIOR TO WORK.
- 3/4" HWS, 3/4" HWR DN TO CUH. SEE DETAIL 6" DS UP TO RD, 6" ODS UP TO ORD.
- 8" DS UP TO RD, 8" ODS UP TO ORD. CONTINUATION BY FIRE PROTECTION CONTRACTOR. FIELD COORDINATE EXACT LOCATION OF BACKFLOW PREVENTER, VALVING, ETC.
- 2" WATER METER WITH 2" REDUCED PRESSURE BACKFLOW PREVENTER. ROUTE RPZ DRAIN PER "BACKFLOW PREVENTER AND DRAIN DETAIL". CONFIRM THAT INSTALLATION MEETS AHJ REQUIREMENTS FOR BACKFLOW PREVENTION ASSEMBLY INSTALLATIONS. PROVIDE SEPARATE SHUTOFF VALVES IN ADDITION TO THE SHUTOFF VALVES THAT ARE INTEGRAL TO THE METER/RPZ ASSEMBLY 4" V UP/DN (4" VTR). COORDINATE/CONFIRM SO THAT VENT IS AT LEAST 10'
- FIRE DEPARTMENT CONNECTION. APPROXIMATE LOCATION SHOWN FOR REFERENCE ONLY. COORDINATE LOCATION, SIZE, REQUIREMENTS, ETC. WITH
- GAS SERVICE BY GAS UTILITY COMPANY. ALL PIPING AFTER METER BY PLUMBING CONTRACTOR. COORDINATE EXACT LOCATION OF METER, REGULATOR, AND SERVICE WITH GAS COMPANY AND OTHER CONTRACTORS TO ENSURE THAT ALL CLEARANCE REQUIREMENTS ARE MET, PARTICULARLY WITH ANY NEARBY BUILDING OPENINGS, INTAKES, MECHANICAL/ELECTRICAL
- 15 ROUTE HW TO HW SUPPLY FROM WHTR. CONNECT DOWNSTREAM OF ALL VALVING. FIELD COORDINATE EXACT CONNECTION LOCATION, ROUTING, ETC.
- 17 CALIBRATED BALANCE VALVE. 18 10" COMBINED DS/ODS DN W/ CO 24" AFF.
- 19 COORDINATE WITH G.C. TO PROVIDE ACCESS PANEL FOR ACCESS TO
- 8" COMBINED DS/ODS DN W/ CO 24" AFF.
- 21 2" CW DN, 2" V DN FOR BACK-TO-BACK WC'S. TEE 1 1/4" CW TO EACH WC. 22 1/2" CW, 1/2" HW DN TO SH.
- 23 PROVIDE WITH ACCESSIBLE ISOLATION SHUT-OFF VALVE IN HALLWAY. NOT SHOWN FOR CLARITY. 4 2" V UP (4" VTR). COORDINATE SO THAT VENT IS AT LEAST 10' FROM ANY
- NEARBY AIR INTAKES. WATER HAMMER ARRESTOR.
- 3/4" HW, 3/4" RHW DN, 1 1/2" V/2" W DN, 1/2" CW DN. TEE 1/2" HW OFF OF
- 28 1/2" HW, 3/4" CW DN TO MSK. MOUNT HB AT 60" AFF. 29 CALIBRATED BALANCE VALVE. REFER TO WATER HEATER DETAIL. 30 HWS/R UP THROUGH CURB TO RTU. FIELD COORDINATE EXACT LOCATION OF
- PRIOR TO INSTALLATION. INSTALL VALVING IN ACCESSIBLE LOCATION. SEE WATER SOFTENER AND BRINE TANK SYSTEM. PROVIDE CONTINUATIONS,
- CONNECTIONS, AND INSTALLATION PER MANUFACTURER'S RECOMMENDATIONS.
- 32 NORMALLY CLOSED BYPASS VALVE. 33 REFER TO WATER HEATER DETAIL FOR CONTINUATION.
- 34 THERMOSTATIC MIXING VALVE. SEE WATER HEATER DETAIL.
- 35 G DN, WITH GAS COCK AND CAP, FOR POTENTIAL FUTURE PATIO FIXTURES. LOCATION SHOWN IS APPROXIMATE. CONFIRM/COORDINATE EXACT LOCATION AND REQUIREMENTS PRIOR TO WORK.
- 36 STACK PIPES ALONG WALL AS ABLE. SHOWN OFFSET FOR CLARITY. FIELD COORDINATE EXACT ROUTING.
- 37 G, HWS/R DN TO BOILER. REFER TO DETAIL FOR CONTINUATION. 38 HOT WATER BOILER AND BOILER CIRCULATION PUMP. SEE DETAIL.
- 39 INLINE HEATING PUMPS (STACKED). SEE DETAIL.
- 40 EXPANSION TANK. BELL & GOSETT MODEL D-144V, OR EQUAL. 41 AIR SEPARATOR. BELL & GOSSETT MODEL R-3, OR EQUAL. SEE DETAIL. 42 PROVIDE CUSTOM RADIANT CEILING PANEL AT THIS LOCATION, 2' WIDE AND APPROX. 6' LENGTH. 155 MWT, 1200 BTU/HR/4' PANEL PERFORMANCE. SMOOTH
- WHITE SURFACE. 1" MIN INSULATION INSTALLED AT REAR OF PANEL. 43 VALVED AND CAPPED PIPES FOR FUTURE EXPANSION. 44 VENT AND COMBUSTION AIR UP THROUGH ROOF. SIZE AND INSTALL PER MANUFACTURER'S RECOMMENDATIONS. COORDINATE/CONFIRM THAT VENT IS
- AT LEAST 10' FROM NEARBY AIR INTAKES. CONCENTRIC AIR INTAKE AND VENT UP THROUGH ROOF. SIZE AND INSTALL PER MANUFACTURER'S RECOMMENDATIONS. COORDINATE/CONFIRM THAT VENT IS AT LEAST 10' FROM NEARBY AIR INTAKES.
- 46 2" FOV UP (4" VTR). COORDINATE/CONFIRM SO THAT VENT IS AT LEAST 10' FROM NEARBY AIR INTAKES.
- 48 1/2" CW DN TO ICE MAKER. STUB THROUGH WALL TO ESCTUCHEON. FIELD COORDINATE EXACT EQUIPMENT LOCATION, CONNECTION REQUIREMENTS, ETC. PRIOR TO WORK.
- 49 PIPING SERVING BREAK ROOM FIXTURES SHOWN FOR CLARITY. PIPING TO DROP IN CHASE AND EXTEND HORIZONTALLY IN WALL BEHIND CABINET TO BE FULLY CONCEALED. 50 1 1/2" LSPR DN OUT THRU WALL & CAPPED FOR FUTURE CONNECTION.
- 1" IRRIGATION METER WITH 1 1/2" REDUCED PRESSURE BACKFLOW PREVENTER. ROUTE RPZ DRAIN PER "BACKFLOW PREVENTER AND DRAIN DETAIL". CONFIRM THAT INSTALLATION MEETS AHJ REQUIREMENTS FOR BACKFLOW PREVENTION ASSEMBLY INSTALLATIONS. PROVIDE SEPARATE SHUTOFF VALVES IN ADDITION TO THE SHUTOFF VALVES THAT ARE INTEGRAL TO THE METER/RPZ ASSEMBLY. OFFSET IRRIGATION RPZ ASSEMBLY TO AVOID INSTALLING DIRECTLY OVER THE BUILDING WATER METER/RPZ ASSEMBLY.
- 52 TRENCH DRAIN. ZURN Z886-GFG WITH GALVANIZED DUCTILE IRON FRAME & SLOTTED GRADE - CLASS F OR EQUAL.
- 54 4" COMBINED DS/ODS DN W/ CO 24" AFF.
- 55 ROUTE PIPING AROUND ROOF ACCESS HATCH LOCATION TO PROVIDE ACCESSIBILITY. ROUTING SHOWN IS FOR CLARITY ONLY. 56 3" DS UP TO RD, 3" ODS UP TO ORD.
- 57 ELECTRICAL EQUIPMENT. MAINTAIN REQUIRED CLEARANCES. JOG/STACK PIPES AS NECESSARY TO MAINTAIN ADEQUATE SPACE FROM ELECTRICAL
- EQUIPMENT. COORDINATE WITH ELECTRICAL CONTRACTOR. TYP ALL.

Architecture Incorporated

415 South Main Avenue P.O. Box 2140 Sioux Falls, South Dakota 57101

Phone: (605) 339-1711

815 St Joseph Street, Suite 203 P.O. Box 8047 Rapid City, South Dakota 57701 Phone: (605) 721-1158

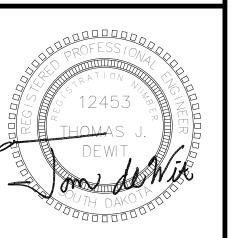



A ssociated **C** onsulting **E** ngineering, I ncorporated 340 S. Phillips Ave. Sioux Falls, SD 57104

(605) 335-3720 Fax 335-6220 E-mail acei@aceinet.com

ACEI PROJ. #121044

 $\mathbf{\Omega}$

DG

in the second space of the 8/11/21 ADDENDUM #1 2 8/16/21 ADDENDUM #2

8.21




GENERAL SHEET NOTES

Architecture

Sioux Falls, South Dakota 57101

815 St Joseph Street, Suite 203 Rapid City, South Dakota 57701

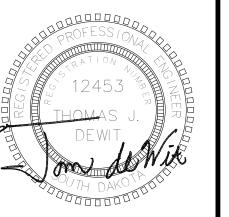


8.30

ELECTRICAL NOTES

- PROVIDE (2) 3" C. RACEWAYS TO PROPERTY LINE OR TELECOM SERVICE PEDESTAL AS COORDINATED WITH SERVICE PROVIDERS TO SUPPORT TELECOMMUNICATIONS AND CATV SERVICES.
- PROVIDE EMPTY 1"C. RACEWAY ROUTED TO TELECOM RACK FOR FUTURE MONUMENT SIGN COMMUNICATIONS. PROVIDE ELECTRICAL CONNECTIONS FOR MONUMENT SIGN INTEGRAL LIGHTING FOR LETTERING. SEE ARCH DETAIL.
- ROUTE TO SERVER ROOM (DEMARC). FRONT EDGE OF SITE LIGHT POLE BASE SHALL BE MINIMUM OF 24" BEHIND
- CURB. TYPICAL. CO-LOCATE WITH POST INDICATOR VALVE (PIV) LOCATION.
- CONTROL EXTERIOR/SITE LIGHTING VIA TIMECLOCK/PHOTOCELL. SEE LIGHTING CONTROL DIAGRAM.
- PROVIDE RACEWAY STUBOUT FOR FUTURE LIGHTING TO ACCOMMODATE FUTURE PARKING LOT EXPANSION.


GENERAL SHEET NOTES

LOCATE ALL PUBLIC AND PRIVATE LINES WITHIN CONSTRUCTION LIMITS. ALL EXTERIOR BRANCH CIRCUITS AND HOMERUNS SHALL BE #10 CU CONDUCTORS IN 1" C. RACEWAYS.

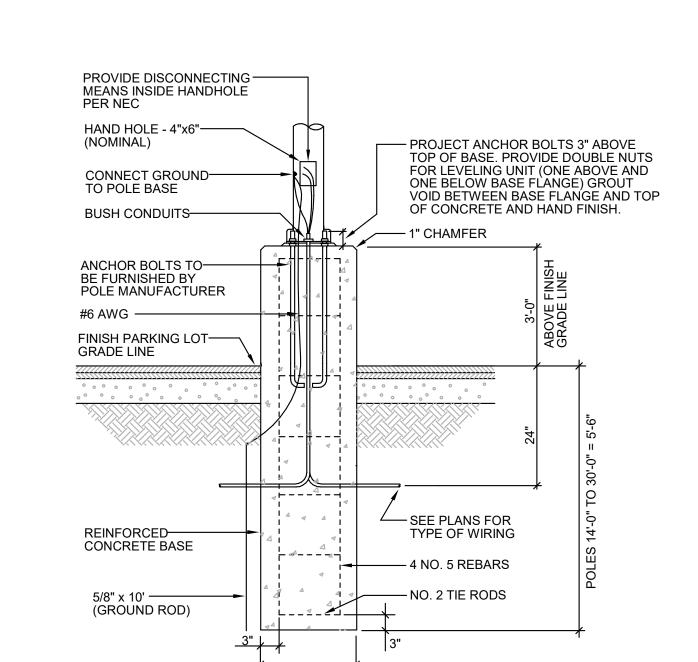


TYPE "AA & AA2" FIXTURE POLE BASE DETAIL NO SCALE

POLES 14'-0"—— TO 30'-0"= 24" SONOTUBE

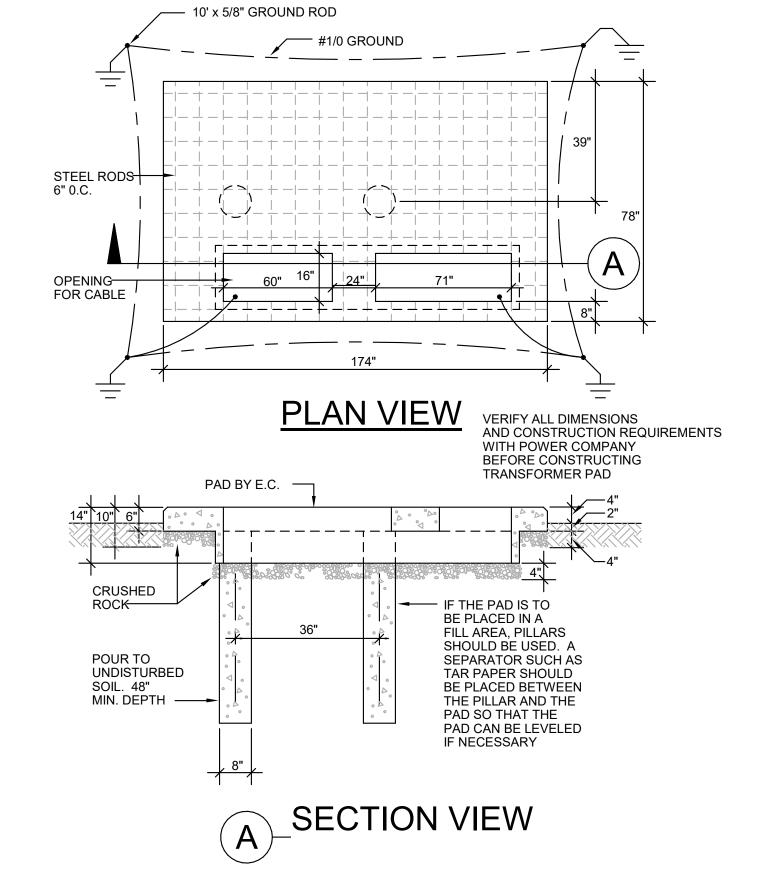


TRANSFORMER PAD DETAIL

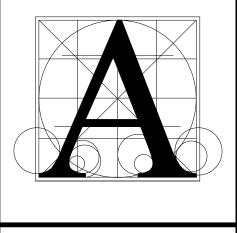

Architecture Incorporated

415 South Main Avenue P.O. Box 2140 Sioux Falls, South Dakota 57101 Phone: (605) 339-1711

815 St Joseph Street, Suite 203 P.O. Box 8047 Rapid City, South Dakota 57701 Phone: (605) 721-1158

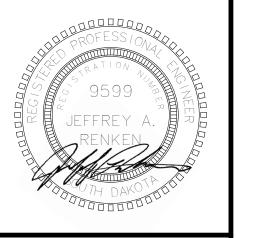




A ssociated **C** onsulting **E** ngineering, I ncorporated 340 S. Phillips Ave. Sioux Falls, SD 57104 (605) 335-3720

Fax 335-6220 E-mail acei@aceinet.com ACEI PROJ. #121044

Sheet cont.

number <u>2932</u> drawn GPR checked JAR 8/11/21 ADDENDUM #1 2 8/16/21 ADDENDUM #2

9.10

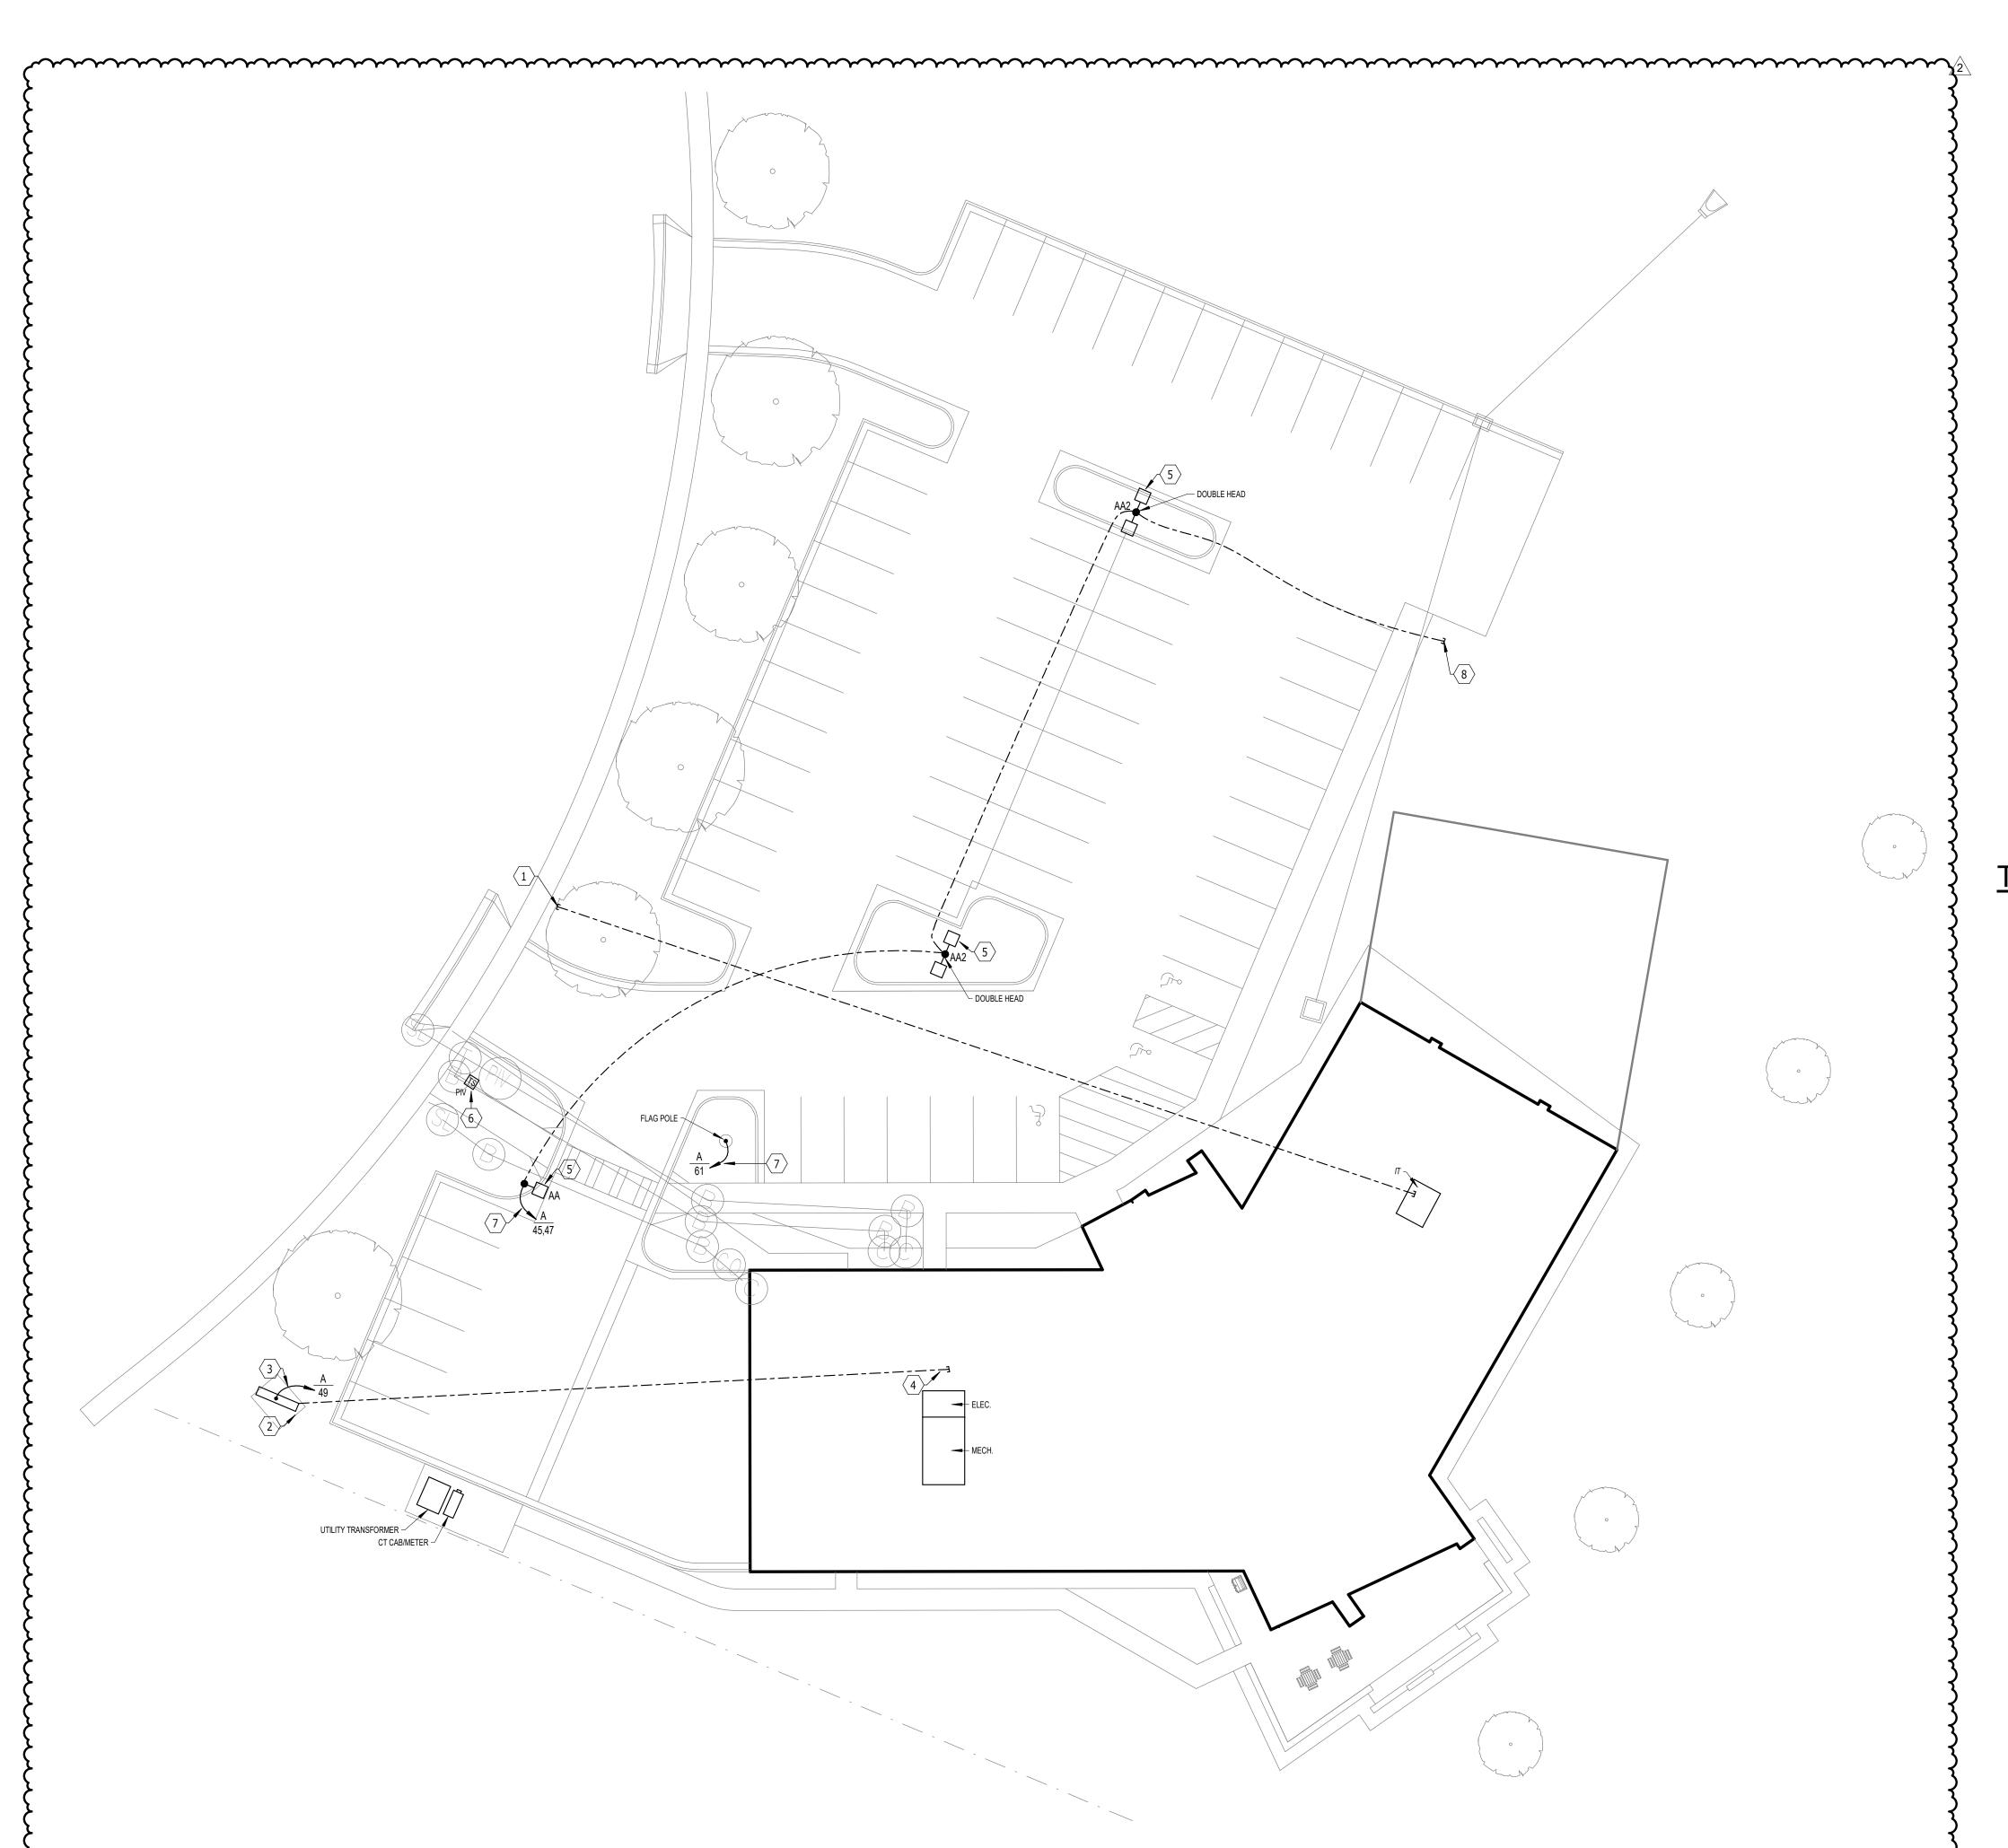

SITE PLAN - ELECTRICAL

SCALE 0 10 20 30 40