

#### **ADDENDUM**

PROJECT:	Teton School District 401 Tetonia Elementary School			ARCHITECT'S PROJECT NO:	1724
OWNER:	Teton Sch	ool District	401	ADDENDUM NUMBER:	1
BID DATE:	03.13.19	TIME:	2:00 p.m.	ADDENDUM DATE:	03.08.19
BID PACKAGE NUMBER:	N/A	•			

IT IS INTENDED THAT BIDS SUBMITTED ARE BASED ON THE INCLUSION OF ALL ADDENDA. PLEASE ATTACH ALL ADDENDA TO THE SPECIFICATIONS AND ACKNOWLEDGE RECEIPT OF SAME IN THE DESIGNATED PLACE ON THE BID FORM.

#### **PART ONE - SUBSTITUTIONS:**

The following manufacturers are accepted as substitutes. The substitute product used on this Project does not relieve the manufacturer and the installer from the intent, responsibilities, and requirements stipulated by the specifications, and the minimum standards implied by originally specified manufacturer.

Any modifications to the work necessary to properly install, build in or otherwise make substituted items or equipment functional and useable shall be at the Contractor's expense.

#### APPROVALS:

- 1. SECTION 093013 CERAMIC TILING
  - a. 093013, 2.5b Ardex 8+9 crack isolation/waterproofing.
  - b. 093013, 2.6a Ardex X4 tile and stone mortar.
  - c. 093013, 2.6b Ardex WA epoxy mortar and grout.
  - d. 093013, 2.7a Ardex FH sanded grout.
  - e. 093013, 2.7b Ardex WA epoxy mortar and grout.
  - f. 093013, 2.8 Adrex Americas Feather Finish.
- SECTION 233400 EXHAUST FANS
  - a. Acme
- SECTION 233713 AIR OUTLETS & INLETS
  - a. Nailor
- 4. SECTION 235226 CONVECTORS
  - a. Rittling
- 5. SECTION 235227 UNIT VENTILATORS (ALTERNATE #1)
  - a. Daikin Applied (McQuay)
- 6.. SECTION 235533 UNIT HEATERS
  - a. Rittling
- 7. SECTION 238220 FAN COIL UNITS
  - a. Daikin Applied (McQuay), Magi Aire,

#### PART TWO - SPECIFICATIONS:

- 1. SECTION 093013 CERAMIC TILING
  - Delete Section 093013, 2.3, B in its entirety.
- 2. SECTION 102239 FOLDING PANEL PARTITIONS
  - a. Delete Section 102239, 1.2, A., 2. & 3. in its entirety.
  - b. Delete Section 102239, 2.1, C. & D. in its entirety.

- c. Revise Section 102239, 2.2, B., from "Panel Operation: Electrically operated, continuously hinged panels." to "Panel Operation: Manually operated, single panels."
- d. Delete Section 102239, 2.6, in its entirety.

#### **PART THREE - DRAWINGS:**

#### **ARCHITECTURAL**

- 1. SHEET A1.1 FLOOR PLAN
  - Revised a wall type in the Restroom area.
  - b. Revised a door tag.
- 2. SHEET A1.2 DIMENSION FLOOR PLAN
  - a. Revised a wall type in the Restroom area.
  - b. Added a Wall Type.
- 3. SHEET A2.1 ROOM FINISH & BUILDING DETAILS
  - a. Revised Room Finish Schedule Legend
  - b. Revised Room Finish Schedule
- 4. SHEET A3.1 BUILDING ELEVATIONS
  - a. Revised a door tag.
  - b. Revised Keyed Notes.
- 5. SHEET A5.1 BUILDING SECTIONS
  - a. Added elevations markers.
- 6. SHEET A7.1 ENLARGED FLOOR PLANS
  - a. Revised a wall type in the Restroom area.
  - b. Added ambulatory stall.
- 7. SHEET A8.1 INTERIOR ELEVATIONS
  - Revised Keyed Notes.
  - b. Removed ceramic wall tile.
- 8. SHEET A8.2 INTERIOR ELEVATIONS
  - a. Revised Keyed Notes.
  - b. Removed ceramic wall tile.
- 9. SHEET A10.1 WINDOW & DOOR SCHEDULES
  - a. Revised Door Schedule.
  - b. Revised Window Schedule.
  - c. Revised Borrowed Lite Type.
  - d. Revised Door Frame Types.
- 10. SHEET A10.3 WINDOW AND DOOR DETAILS
  - a. Added folding door partition details.
    SHEET A11.1 REFLECTED CEILING PLAN
  - a. Revised Keyed Note.

#### **STRUCTURAL**

11.

- 1. SHEET S2.1 FOUNDATION PLAN
  - Revised floor slab in the Restroom area.
- 2. SHEET S2.2 ROOF FRAMING PLAN
  - a. Revised wall types in the Restroom area.

#### **ELECTRICAL**

- 1. SHEET E3.1 FLOOR PLAN SPECIAL SYSTEMS
  - a. Provide Data for Wireless Access point in Waiting Rm 103, See attached sheet.
  - b. Provide Data on exterior of building for exterior Wireless Access Point, See attached sheet.

#### PART FOUR - ATTACHMENTS:

SHEET A1.1 – FLOOR PLAN

SHEET A1.2 – DIMENSION FLOOR PLAN

SHEET A2.1 - ROOM FINISH & BUILDING DETAILS

SHEET A3.1 – BUILDING ELEVATIONS

SHEET A5.1 – BUILDING SECTIONS

SHEET A7.1 – ENLARGED FLOOR PLANS

SHEET A8.1 - INTERIOR ELEVATIONS

SHEET A8.2 - INTERIOR ELEVATIONS

SHEET A10.1 – WINDOW & DOOR SCHEDULES

SHEET A10.3 – WINDOW AND DOOR DETAILS


SHEET A11.1 – REFLECTED CEILING PLAN

SHEET S2.1 – FOUNDATION PLAN

SHEET S2.2 - ROOF FRAMING PLAN

SHEET E3.1 – FLOOR PLAN SPECIAL SYSTEMS

#### **END OF ADDENDUM**

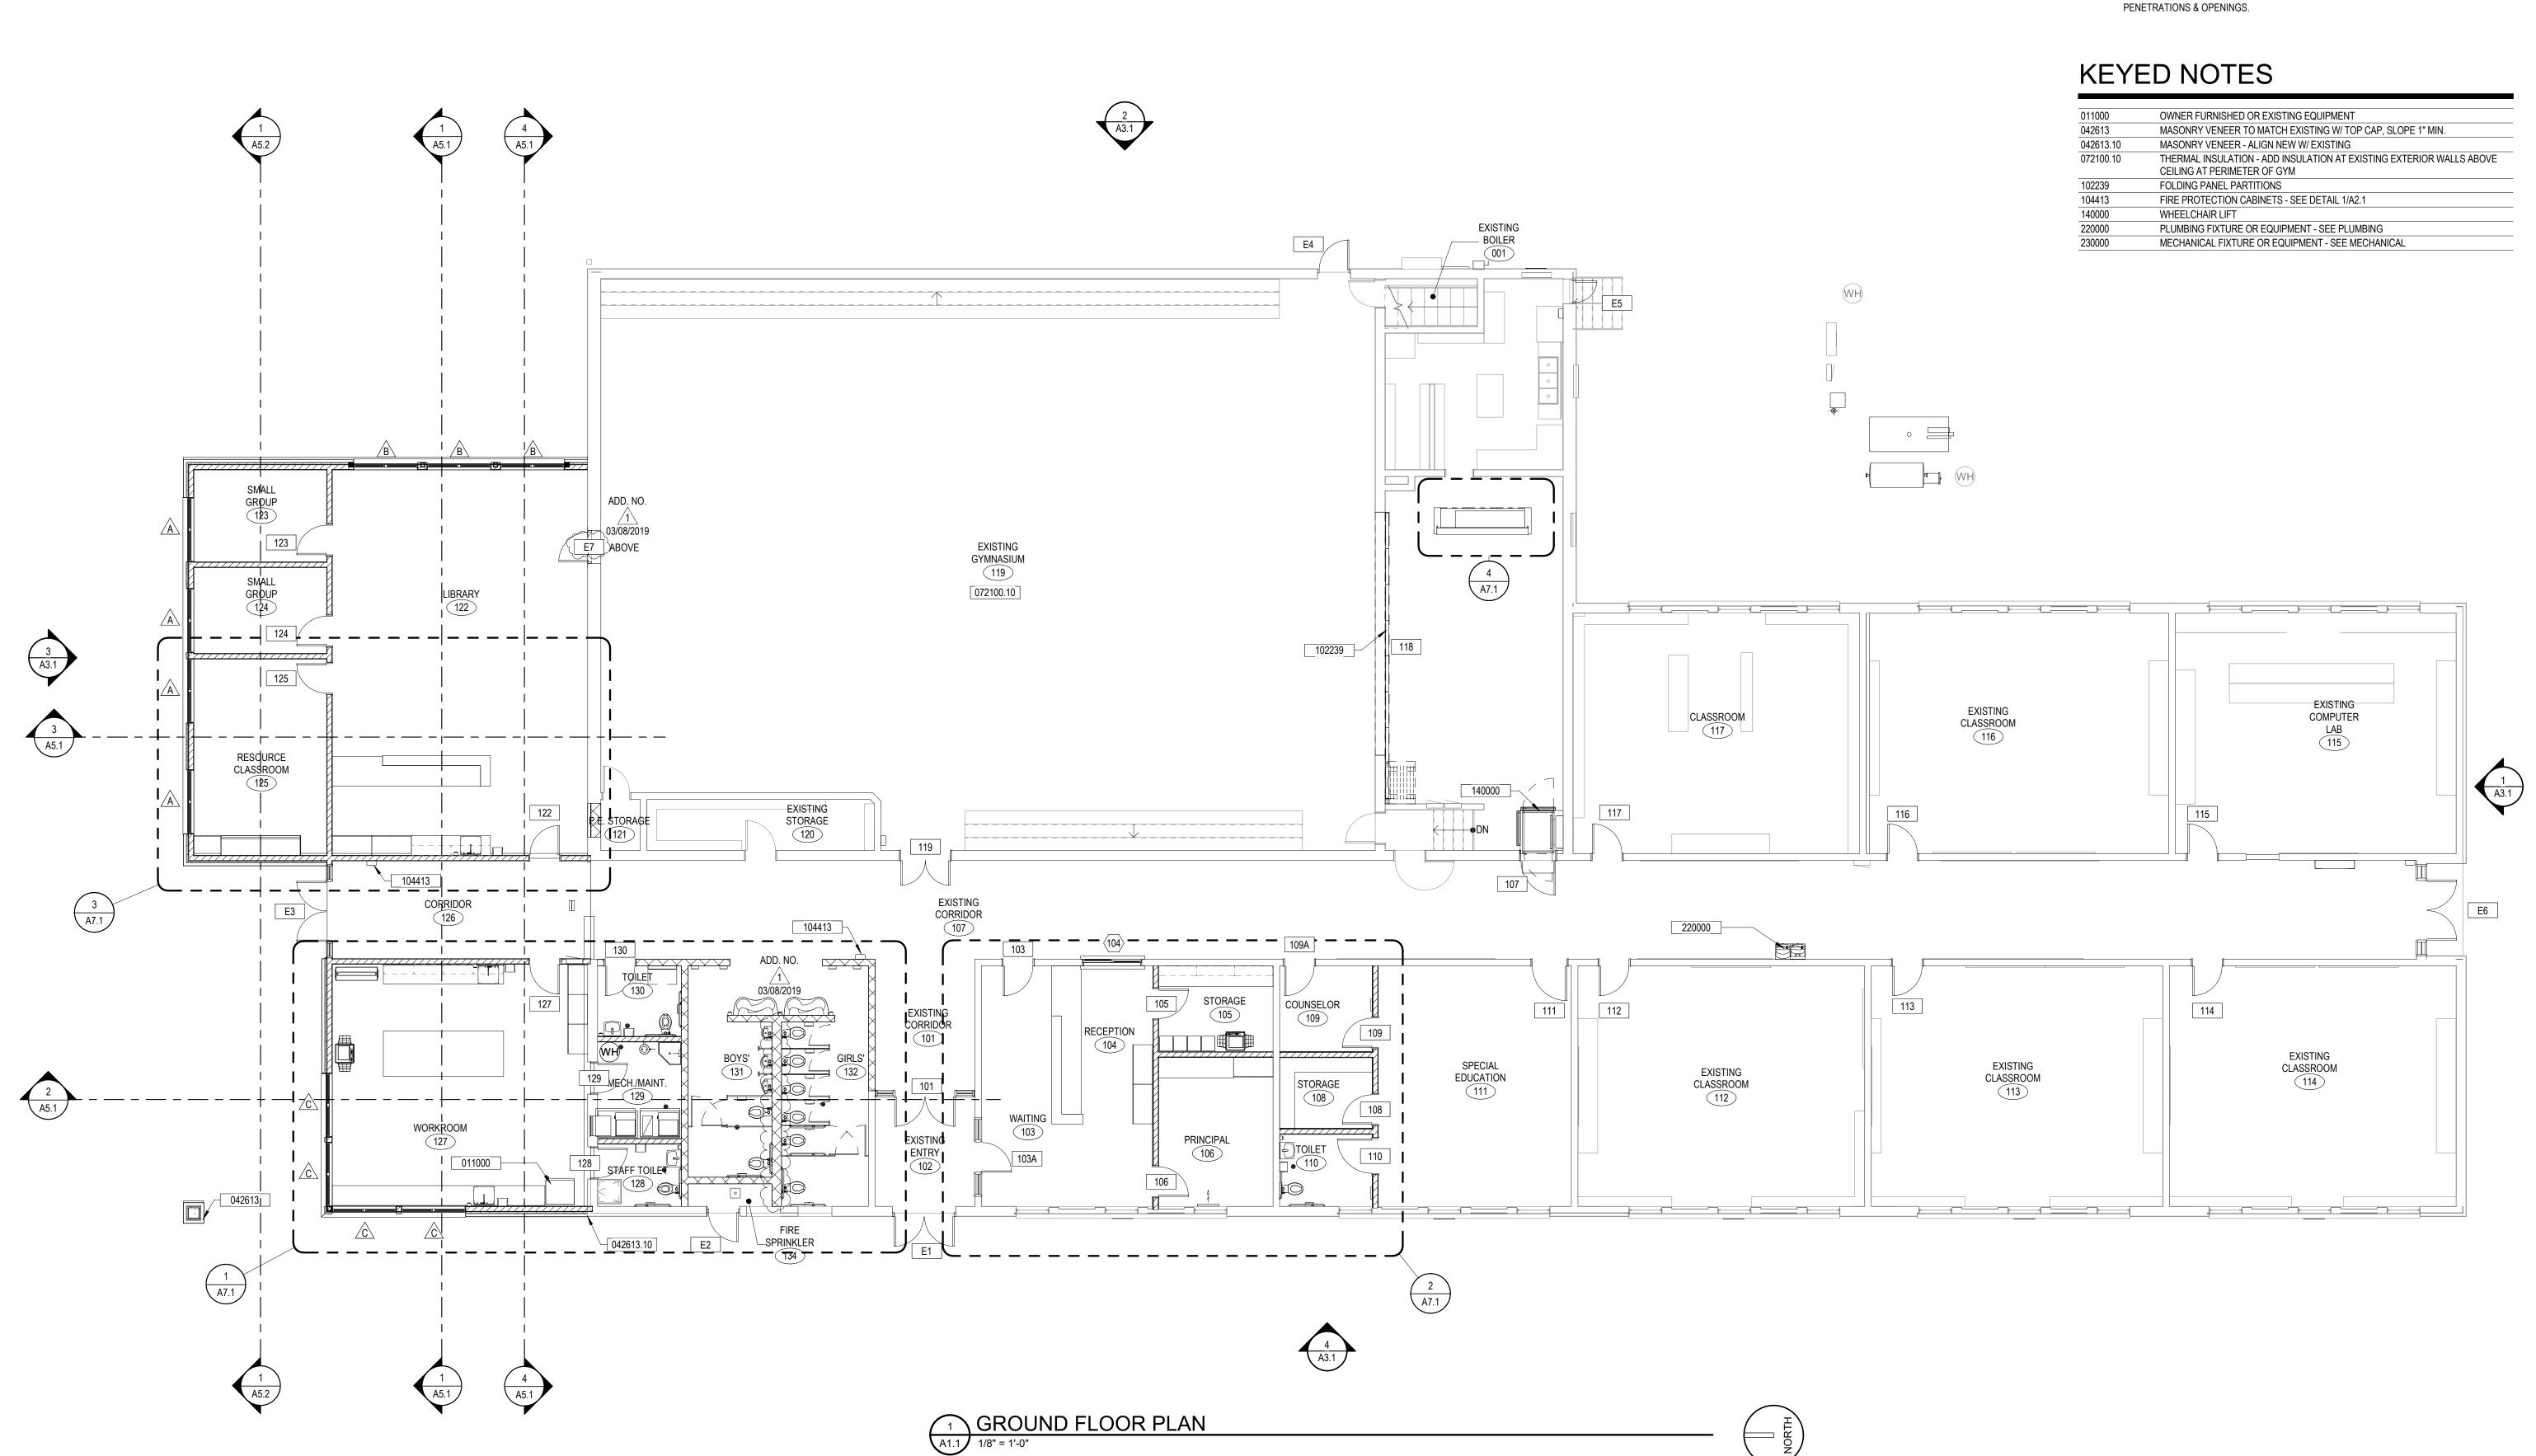

#### **GENERAL NOTES**

- 1. PROVIDE BACKING PLATES IN STUD WALLS FOR ALL HANDRAILS, GRAB BARS, TOILET ACCESSORIES, CASEWORK, ETC.
- 2. IF A CONFLICT OR DISCREPANCY OCCURS BETWEEN FLOOR PLANS OF ARCHITECTURAL, STRUCTURAL, MECHANICAL OR ELECTRICAL DRAWINGS, CONTACT ARCHITECT FOR
- CLARIFICATION.
  3. SEE PLUMBING PLANS FOR EXACT LOCATION OF FLOOR DRAINS. SLOPE ALL CONCRETE
  - SLABS TOWARDS DRAINS. ALL G.W.B. TO BE 5/8" TYPE 'X', EXCEPT AS NOTED.
  - USE WATER RESISTANT G.W.B. IN ALL WET AREAS INDICATED TO RECIEVE G.W.B. JANITOR AREAS & TOILET ROOMS @ FIXTURE WALLS ONLY.
  - PROVIDE CASING BEAD & CAULK WHERE G.W.B. ABUTS DISSIMILAR MATERIAL, EXCEPT STONE.
  - DIMENSIONS ARE TO FACE OF BLOCK, FACE OF STUD OR GRID LINE UNLESS NOTED
  - OTHERWISE.
  - LOCATE DOOR R.O. 4 1/2" FROM ADJACENT STUD WALL UNLESS NOTED OTHERWISE. SEE A1 SERIES FOR WALL TYPES.
- 0. SEE A2 SERIES FOR ROOM FINISH SCHEDULE.
- SEE A7 SERIES FOR ENLARGED PLANS.
  SEE A8 SERIES FOR INTERIOR ELEVATIONS FOR TRIM, CASEWORK, TOILET
- ACCESSORIES, ETC.
- SEE A10 SERIES FOR DOOR & WINDOW SCHEDULES. SEE A11 SERIES FOR REFLECTED CEILING PLANS.
- ALL VAPOR BARRIERS IN LOCATIONS NOT COVERED WITH G.W.B. MUST MEET FLAME SPREAD 25 SEE SPECS. ALL VAPOR BARRIERS MUST BE SEALED OR TAPED AT ALL

DCGrchiteC N. Main St., Ste. 200 ggs, Idaho 83422 3.354.8036



Ownership & Use of Documents

Drawings and specifications, as instruments of professional service are and shall remain the property of the architect. These documents are not to be used in whole or in part for any project or purposes whatsoever, without the prior specific written authorization of GPC Architects PLLC.

authorization of GPC Architects PLLC.

ETON SCHOOL DISTRICT, TETONIA ELEMENTARY SCHOOL

revisions
no. description date
1 ADD #1 03/08/20


revisions
no. description date
1 ADD #1 03/08/2019

project: 1724 date: 12/07/2018

FLOOR PLAN

sheet<sup>.</sup>

A1.1

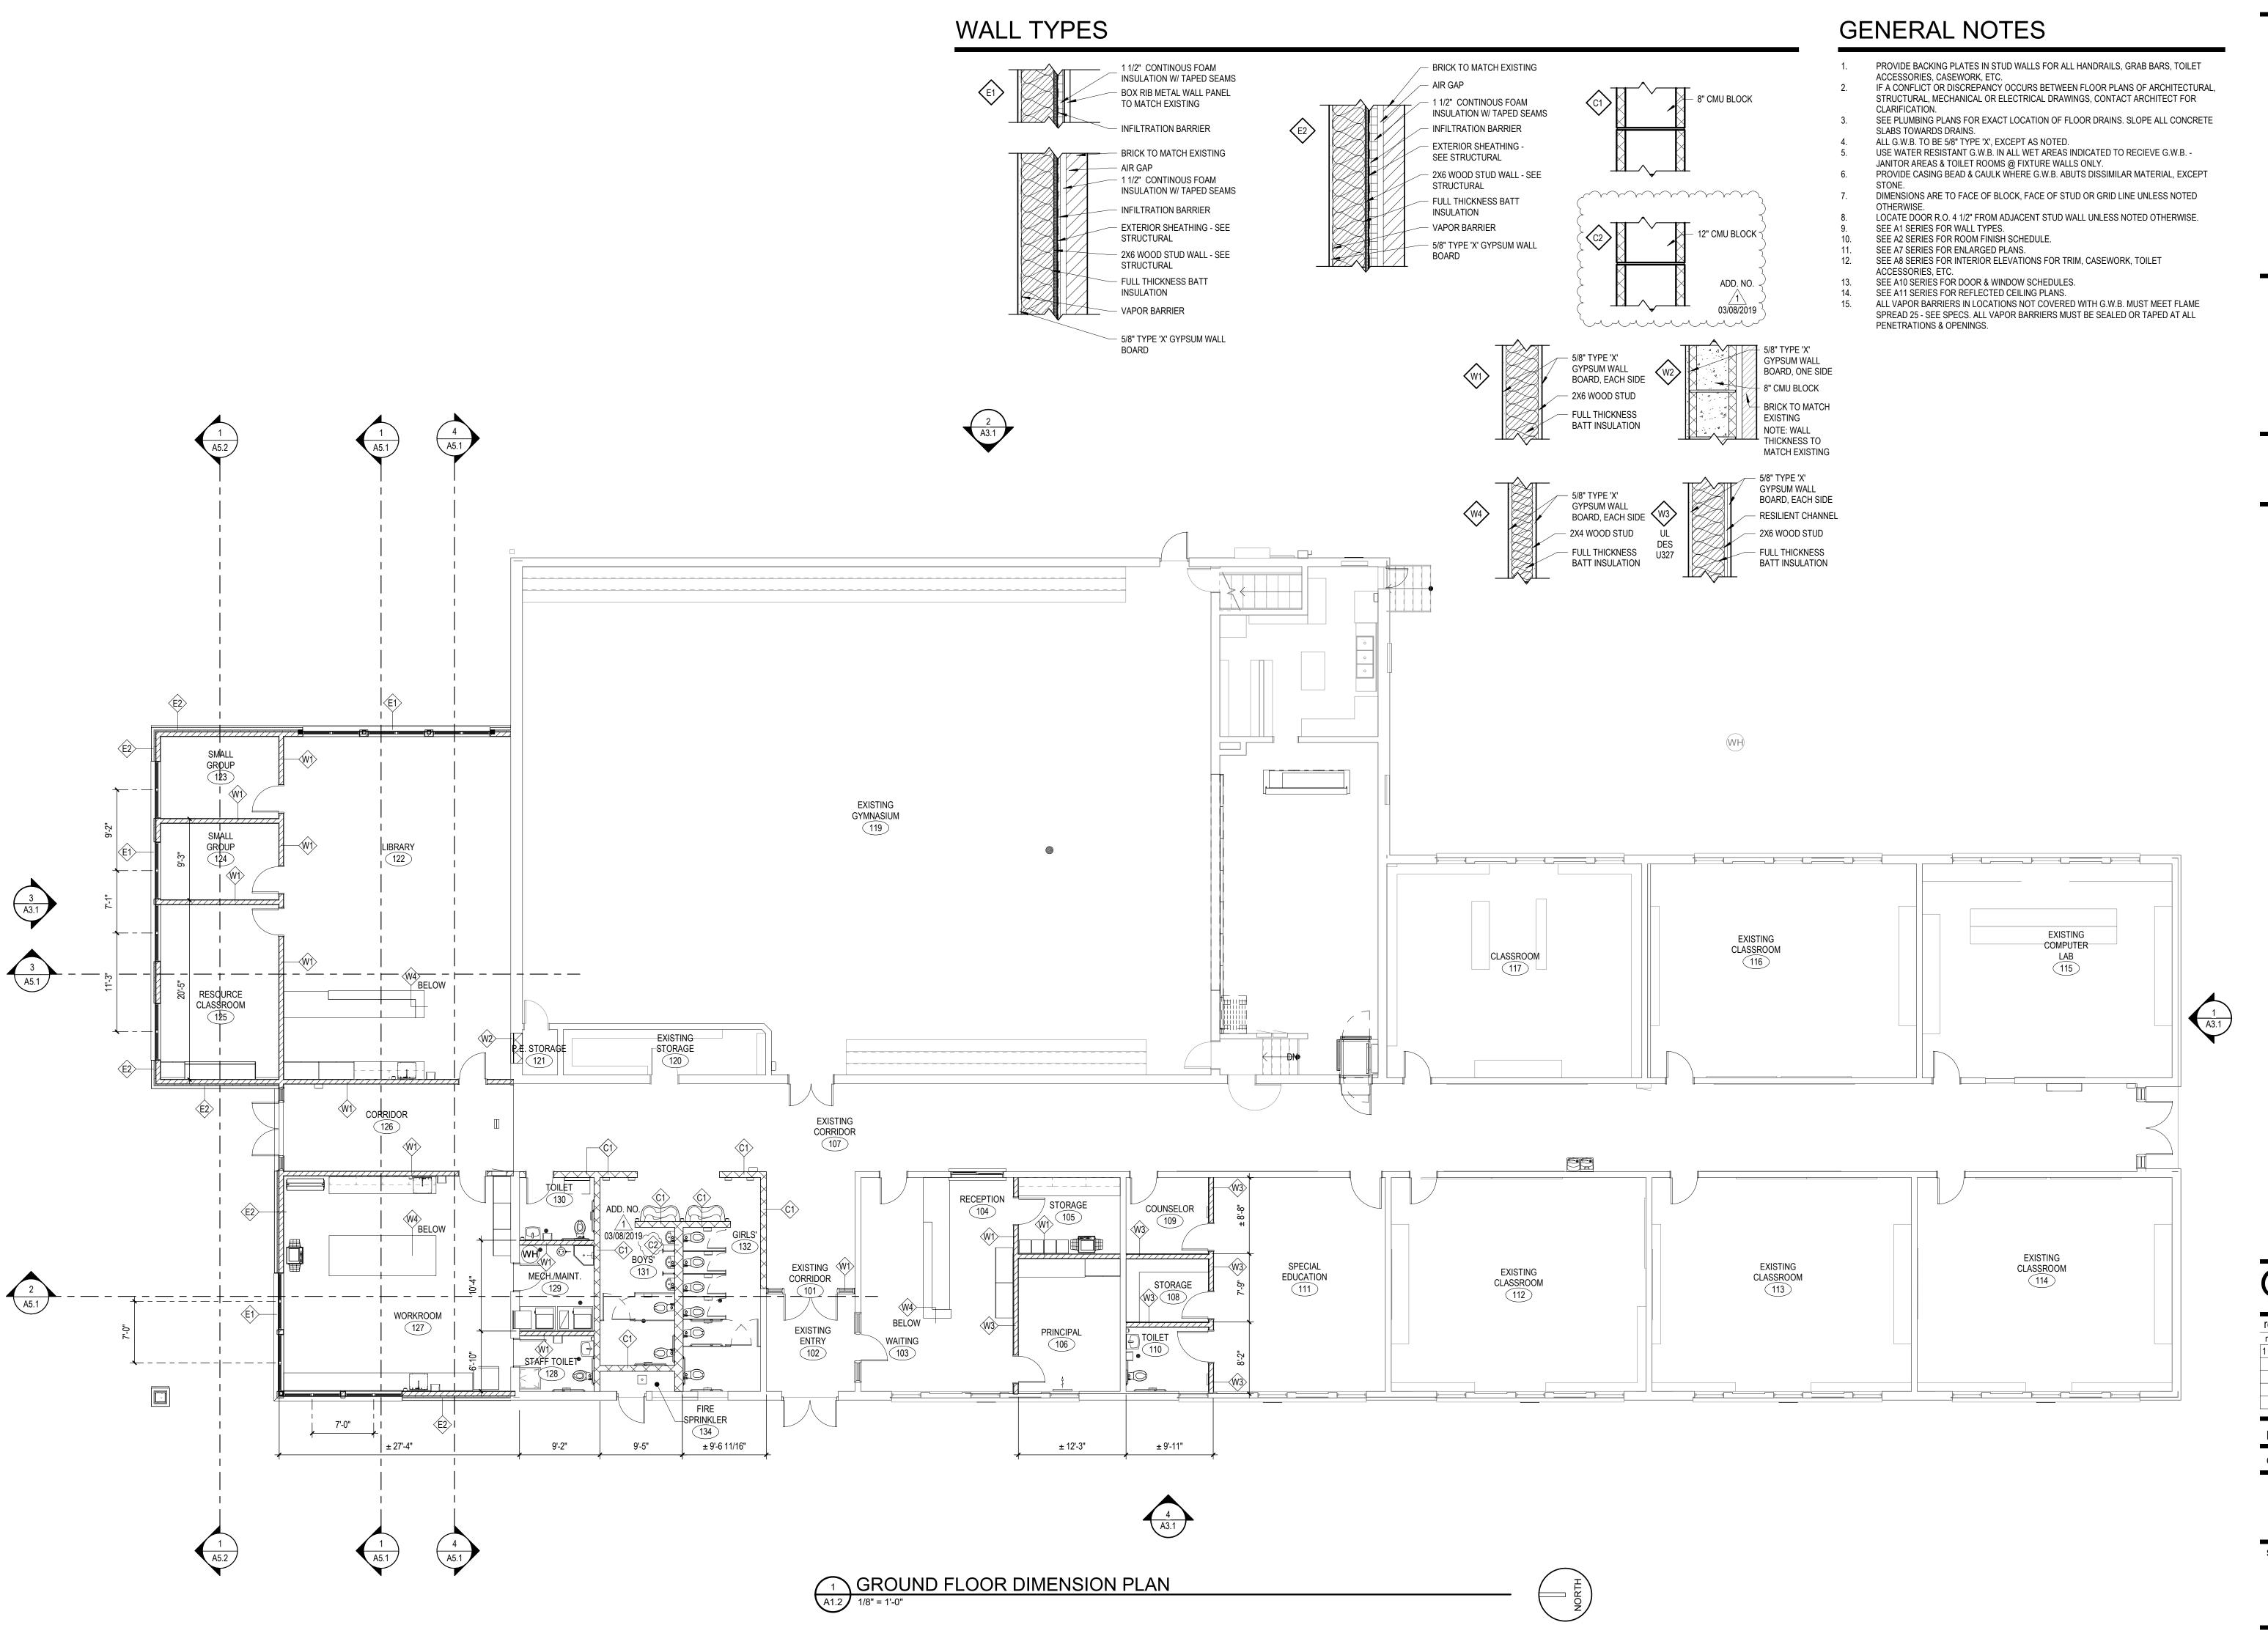

LICENSED ARCHITECT AR-984552 GARETT PAUL CHADWICK STATE OF IDAHO

t., Ste. 2 83422

Ownership & Use of Documents Drawings and specifications, as instruments of professional service are and shall remain the property

of the architect. These documents are not to be used in whole or in part for any project or purposes whatsoever, without the prior specific written authorization of GPC Architects PLLC.

no. description

project: 1724 date: 12/07/2018

> **DIMENSION** FLOOR PLAN

A1.2

# **TETONIA ELEMENTARY SCHOOL** 2019

## **BOARD OF TRUSTEES**

SUSAN BATES - CLERK CHRIS ISAACSON **DELWYN JENSEN** 

BEN KEARSLEY MARY MELLO NAN PUGH

## SUPERINTENDENT

MONTE WOOLSTENHULME

## **ARCHITECT**

**GPC ARCHITECTS** 





## CONTRACTOR


**HEADWATERS CONSTRUCTION** 

INFORMATION SHOWN IN THE SAMPLE DEDICATION PLAQUE IS FOR REFERENCE ONLY. THE PERSONNEL IN THEIR RESPECTIVE POSITIONS AT THE TIME OF PRIOR TO ORDERING THE PLAQUE.


5 BUILDING DEDICATION PLAQUE

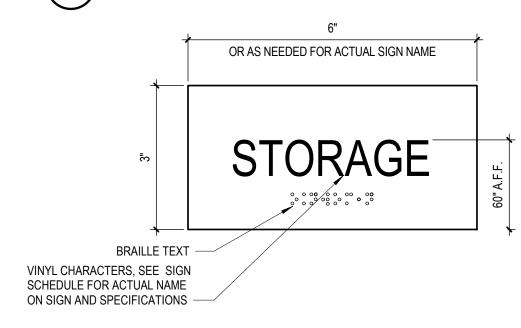


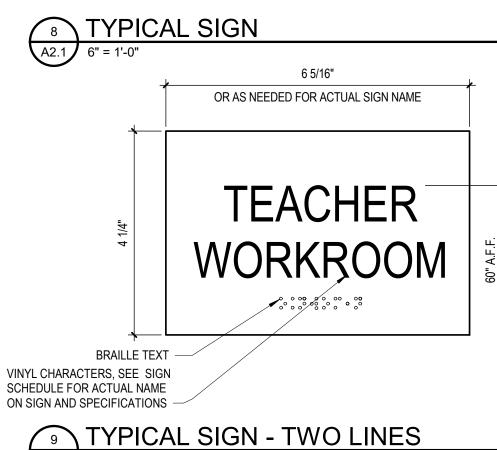

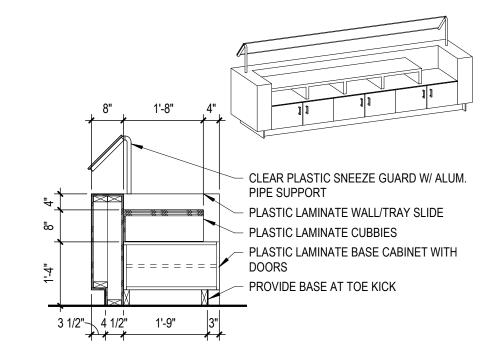




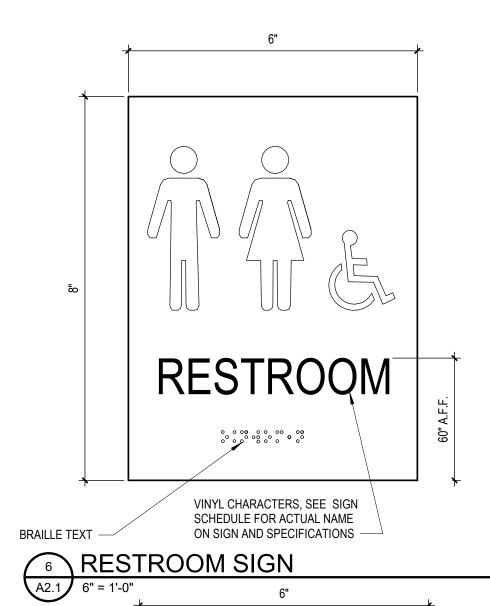

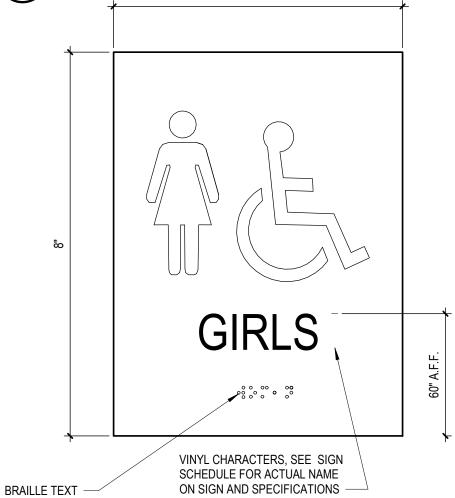


7 GIRLS A2.1 6" = 1'-0"

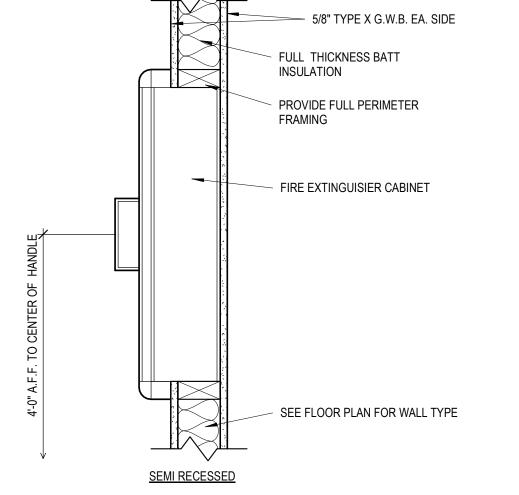


NOTE: SIMILAR CONDITION FOR ELECTRICAL PANELS & VALVE BOXES

TYP. FIRE EXTINGUISHER


1 1/2" = 1'-0"

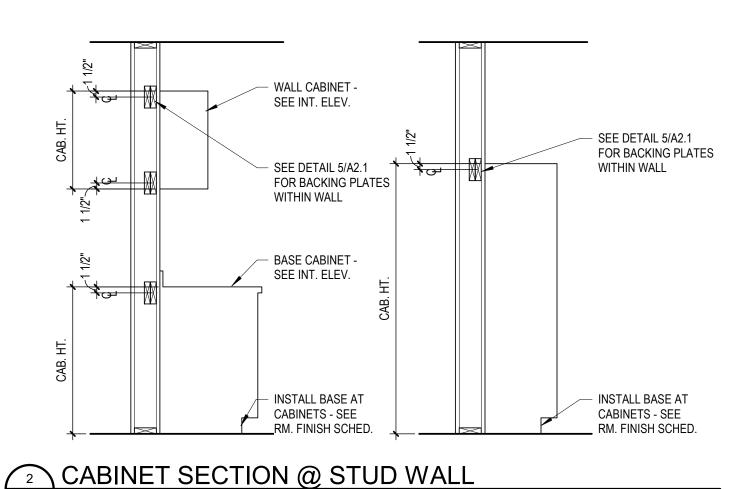

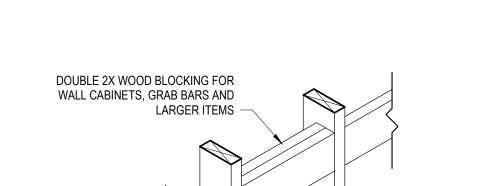

SINGLE 2X WOOD BLOCKING FOR ALL MOUNTED TOILET ACCESSORIES, LOWER CASEWORK AND SMALLER ITEMS

WOOD STUD BACKING DETAIL

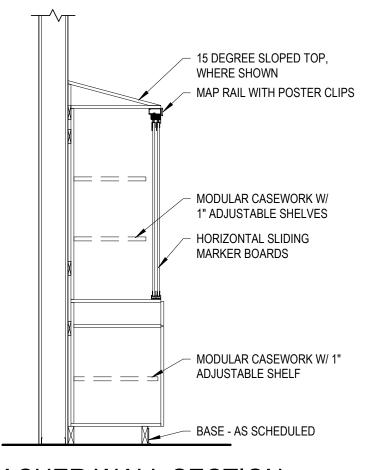

TYP. TEACHER WALL SECTION

#### FINISH SCHEDULE REMARKS

SOME EXISTING FLOORING IS TO REMAIN - SEE PLAN FOR TRANSITION BID ALTERNATE #4 - REPLACE FLOORING & WALL BASE IN EXISTING KITCHEN & THE SERVING AREA PORTION OF CAFETERIA

## **GENERAL NOTES**

- PROVIDE DESIGNATED BASE FROM ROOM FINISH SCHEDULE AROUND BOTTOM OF CABINETS, UNLESS OTHERWISE NOTED.
- SEE A11 SERIES FOR REFLECTED CEILING PLANS.
- SEE A8 FOR INTERIOR ELEVATIONS FOR CASEWORK, TOILET ACCESSORIES, ETC.
- PROVIDE IN-WALL BLOCKING/BACKING FOR WALL MOUNTED ITEMS SEE DETAIL 3/A2.

#### ROOM FINISH SCHEDULE LEGEND

OR	BASE	WALL	CEILING
TILE CARPETING	B1 4" RESILIENT BASE	W1 PAINTING - TEXTURED TYPE 'X' GYPSUM	C1 PAINTED, TEXTURED TYPE 'X' GYPSUM
RESILIENT TILE FLOORING	B2 NO BASE	BOARD	BOARD
TILE CARPETING - WALK OFF	B3 6" RUBBER BASE	W2 PAINTING - CONCRETE MASONRY UNIT	C2 EPOXY PAINTED, TEXTURED, TYPE 'X'
SEALED CONCRETE		W3 EPOXY PAINTING - TEXTURED TYPE 'X'	GYPSUM BOARD
CERAMIC TILING		GYPSUM BOARD	C3 EXISTING CEILING TO REMAIN
RESILIENT SHEET FLOORING	<del></del>	W4 EPOXY PAINTING - CONCRETE MASONRY UNIT	C4 24" X 48" RADAR ILLUSION 12"X12" TILE LOOK ACOUSTIC TILE & GRID SYSTEM -
		W5 EXISTING BRICK TO REMAIN, CLEAN	SEE SPECS

## ROOM FINISH SCHEDULE

					WA	ALLS		CE	ILINGS	
NUMBER	NAME	FLOOR FINISH	BASE	NORTH	EAST	SOUTH	WEST	CEILING	CEILING HT. (±)	REMARKS
001	EXISTING BOILER			-	-	-	-	C3	-	
101	EXISTING CORRIDOR	F3	B1	-	-	-	W2	C3	-	
102	EXISTING ENTRY	F3	B1	-	-	-	-	C3	-	
103	WAITING	F1	B1	W2	W2	W1	W1,W2	C4	±10'-4"	
104	RECEPTION	F1	B1	W2	W2	W1	W1,W2	C4	±10'-4"	
105	STORAGE	F1	B1	W1	W2	W2	W1	C4	8'-6"	
106	PRINCIPAL	F1	B1	W1	W1	W2	W1,W2	C4	8'-6"	
107	EXISTING CORRIDOR	F1	B1	-	W2	-	W2	C3, C4	MATCH EXISTING	1
108	STORAGE	F1	B1	W2	W1	W1	W1 ADD.	NO. C1	8'-6"	
109	COUNSELOR	F1	B1	W2	W2	W1	₩1 /₁	C4	8'-6"	
110	TOILET	F5	B1	W4	W3	W3	W4 03/08/2	2019 C2	8'-6"	
111	SPECIAL EDUCATION	F1	B1	W1	W2	W2	W1,W2	C4	±10'-4"	
112	EXISTING CLASSROOM	-	-	-	-	-	-	C3	-	
113	EXISTING CLASSROOM	-	-	-	-	-	-	C3	-	
114	EXISTING CLASSROOM	-	-	-	-	-	-	C3	-	
115	EXISTING COMPUTER LAB	-	-	-	-	-	-	C3	-	
116	EXISTING CLASSROOM	-	-	-	-	-	-	C3	-	
117	CLASSROOM	-	-	-	-	-	-	C3	-	
118	EXISTING MULTIPURPOSE ROOM	F6, (E)	B3	-	-	-	-	C3	-	1, 2
119	EXISTING GYMNASIUM	-	-	-	-	-	-	C3	-	
120	EXISTING STORAGE	-	-	-	-	-	-	C3	-	
121	P.E. STORAGE	-	-	-	-	-	-	C3	-	
122	LIBRARY	F1	B1	W1	W5	W1	W1	C4	8'-6"	
123	SMALL GROUP	F1	B1	W1	W1	W1	W1	C4	8'-6"	
124	SMALL GROUP	F1	B1	W1	W1	W1	W1	C4	8'-6"	
125	RESOURCE CLASSROOM	F1	B1	W1	W1	W1	W1	C4	8'-6"	
126	CORRIDOR	F1, F3	B1	W1	W1	-	W1	C4	8'-6"	1
127	WORKROOM	F2	B1	W1	W1	W5	W1	C4	8'-6"	
128	STAFF TOILET	F5	B1	W4	W3	W4	W4	C2	8'-6"	
129	MECH./MAINT.	F4	B1	W2	W1	W2	W1	C1	8'-6"	
130	TOILET	F4	B1	W4		W4 \( \)	\\/\2	CO	8'-6"	
131	BOYS'	F4	B1	W4 W4	W4	W4	W4 ADD.	NO.————	8'-6"	
132	GIRLS'	F4	B1	W4, ,	, ,W4 ,	, , W4 ,	$\frac{1}{\sqrt{1}}$	Co	8'-6"	
133	EXISTING KITCHEN	F6	B3				03/08/2	2019 C3	-	2
134	FIRE SPRINKLER	F4	B1	W2	W1	W1	W2	C1	STRUCT.	_

#### SIGN SCHEDULE

NAME	NUMBER	ACTUAL NAME ON SIGN	NUMBER OF SIGNS	DETAIL
EVICTING DOUGE	204			
EXISTING BOILER	001			
EXISTING CORRIDOR	101	0.5510.5		
EXISTING ENTRY	102	OFFICE	1	
WAITING	103			
RECEPTION	104	OFFICE	1	
STORAGE	105	STORAGE	1	
PRINCIPAL	106	PRINCIPAL	1	
EXISTING CORRIDOR	107			
STORAGE	108	STORAGE	11	
COUNSELOR	109	COUNSELOR	1	
TOILET	110	TOILET	1	
SPECIAL EDUCATION	111	CLASSROOM	1	
EXISTING CLASSROOM	112			
EXISTING CLASSROOM	113			
EXISTING CLASSROOM	114			
EXISTING COMPUTER LAB	115			
EXISTING CLASSROOM	116			
CLASSROOM	117			
EXISTING MULTIPURPOSE ROOM	118			
EXISTING GYMNASIUM	119			
EXISTING STORAGE	120			
P.E. STORAGE	121			
LIBRARY	122	LIBRARY	1	
SMALL GROUP	123			
SMALL GROUP	124			
RESOURCE CLASSROOM	125			
CORRIDOR	126			
WORKROOM	127	TEACHER WORKROOM	1	
STAFF TOILET	128	TOILET	1	
MECH./MAINT.	129			
TOILET	130	TOILET	1	
BOYS'	131	BOYS	<u>.</u> 1	
GIRLS'	132	GIRLS	<u>.</u> 1	
EXISTING KITCHEN	133	- <del></del>	·	
FIRE SPRINKLER	134			




Ownership & Use of Documents Drawings and specifications, as instruments of professional service are and shall remain the prope of the architect. These documents are not to be used in whole or in part for any project or purposes whatsoever, without the prior specific written authorization of GPC Architects PLLC.

date: 12/07/2018

**ROOM FINISH &** BUILDING **DETAILS** 

A2.1

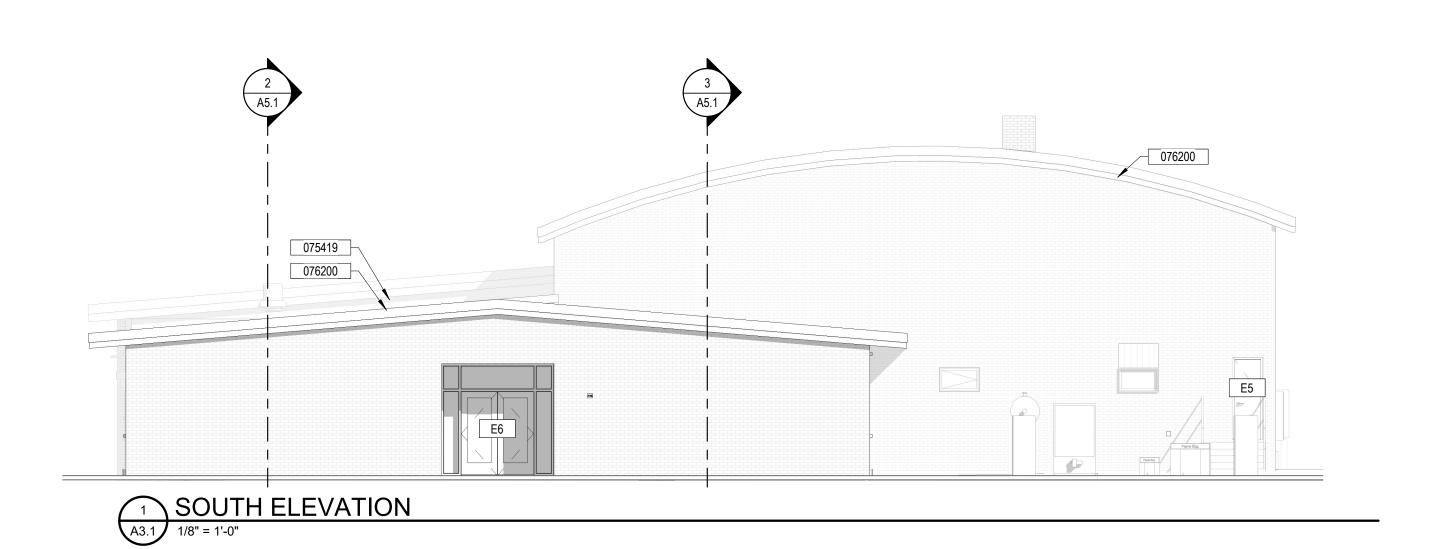

## **KEYED NOTES**

ADD. NO.	042613	MASONRY VENEER TO MATCH EXISTING W/ TOP CAP, SLOPE 1" MIN.
1	042613.30	(MASONRY VENEER - CONTROL JOINT)
03/08/2019	074213	METAL WALL PANELS
	075419	POLYVINYL-CHLORIDE (PVC) ROOFING
	076200	SHEET METAL FLASHING AND TRIM
	085200	ALUMINUM CLAD WOOD WINDOWS
	230000	MECHANICAL FIXTURE OR EQUIPMENT - SEE MECHANICAL
	260000	ELECTRICAL FIXTURE OR EQUIPMENT - SEE ELECTRICAL

## GENERAL NOTES


REQUIREMENTS.

1.	SEE A3 SERIES FOR EXTERIOR ELEVATIONS.
2.	SEE A5 SERIES FOR BUILDING SECTIONS.
3.	SEE A6 SERIES FOR WALL SECTIONS.
4.	SEE A8 SERIES FOR INTERIOR ELEVATIONS.
5.	SEE A10 SERIES FOR DOOR & WINDOW SCHEDULES.
6.	ALL VAPOR BARRIERS MUST BE SEALED OR TAPED AT ALL PENETRATIONS & OPEN
7.	COORDINATE THE INSTALLATION OF ALL MATERIALS WITH OTHER TRADES. SEE
	STRUCTURAL MECHANICAL PLUMRING AND FLECTRICAL DRAWINGS FOR




Ownership & Use of Documents Drawings and specifications, as instruments of professional service are and shall remain the property of the architect. These documents are not to be used in whole or in part for any project or purposes


whatsoever, without the prior specific written authorization of GPC Architects PLLC.

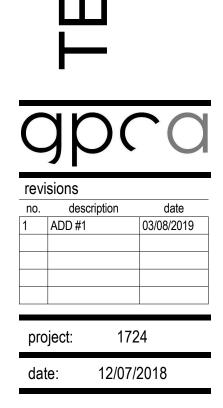


BUILDING ELEVATIONS

A3.1

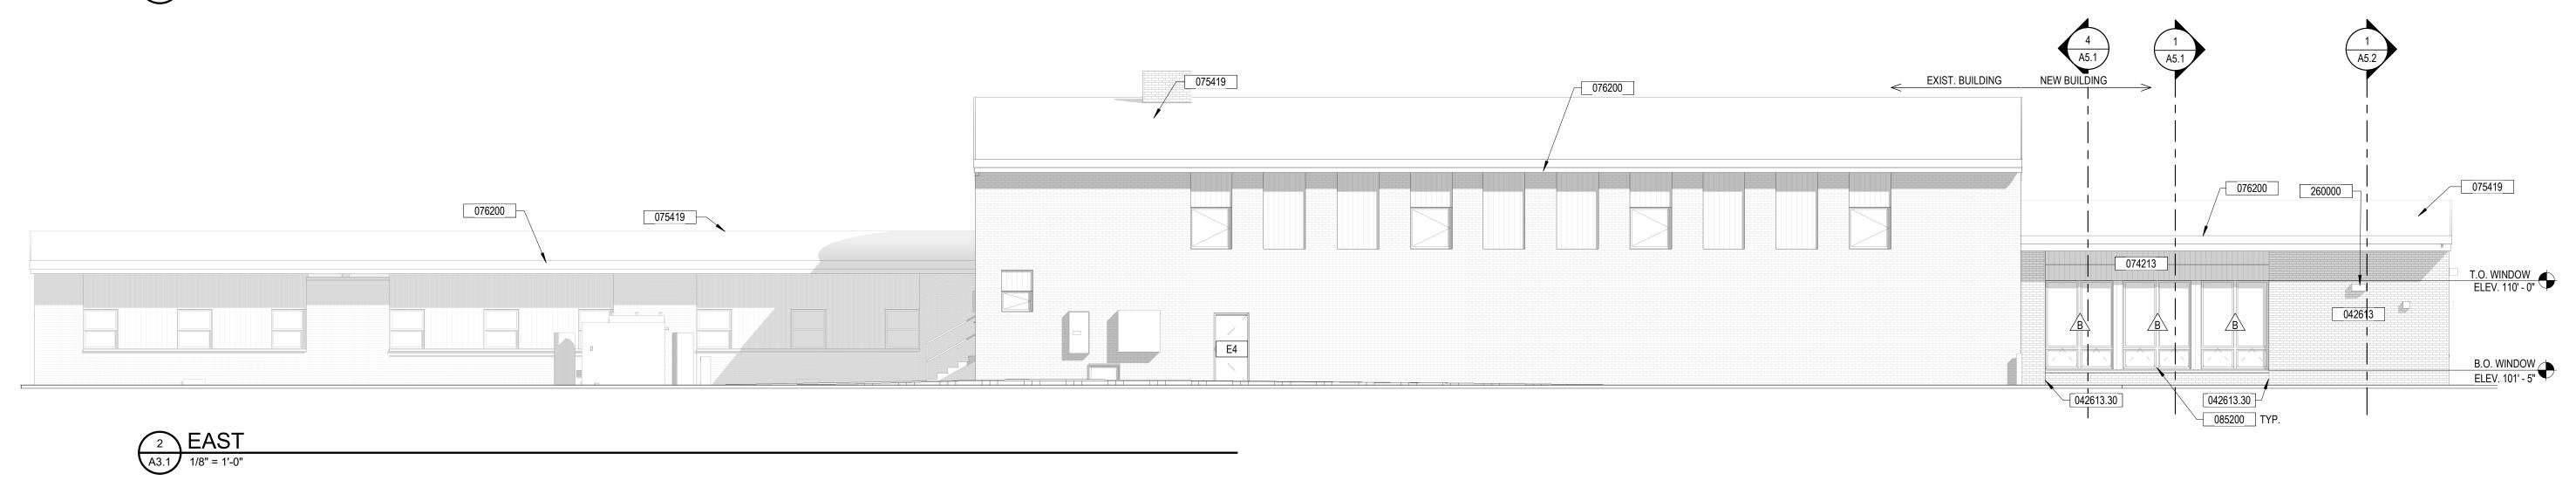

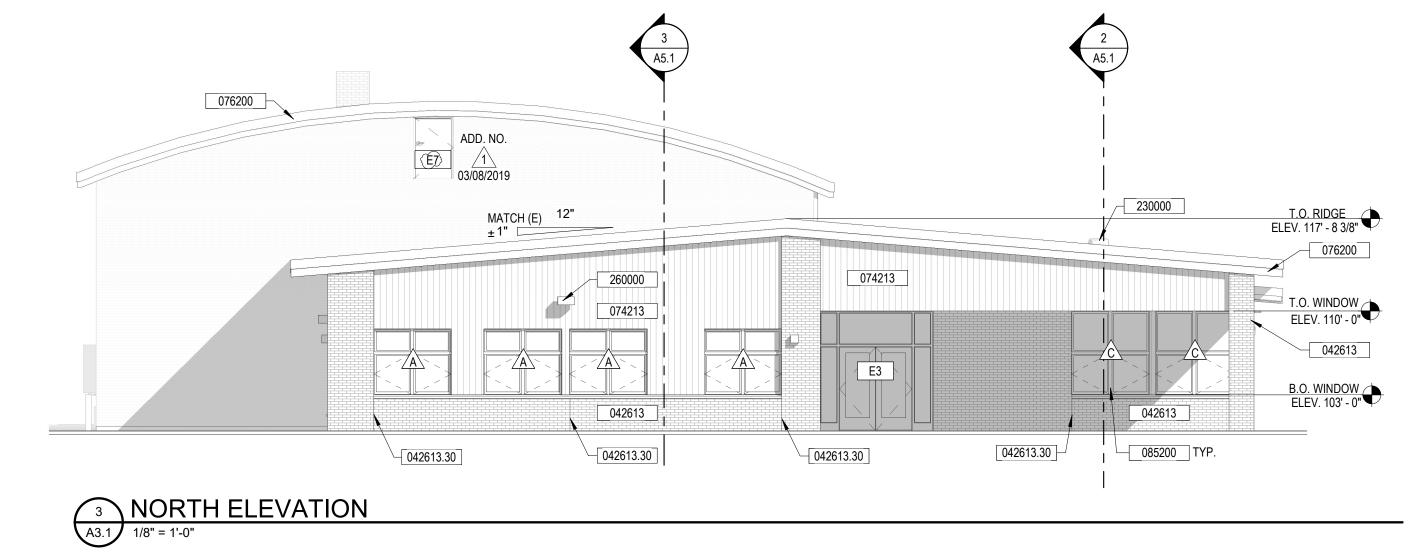

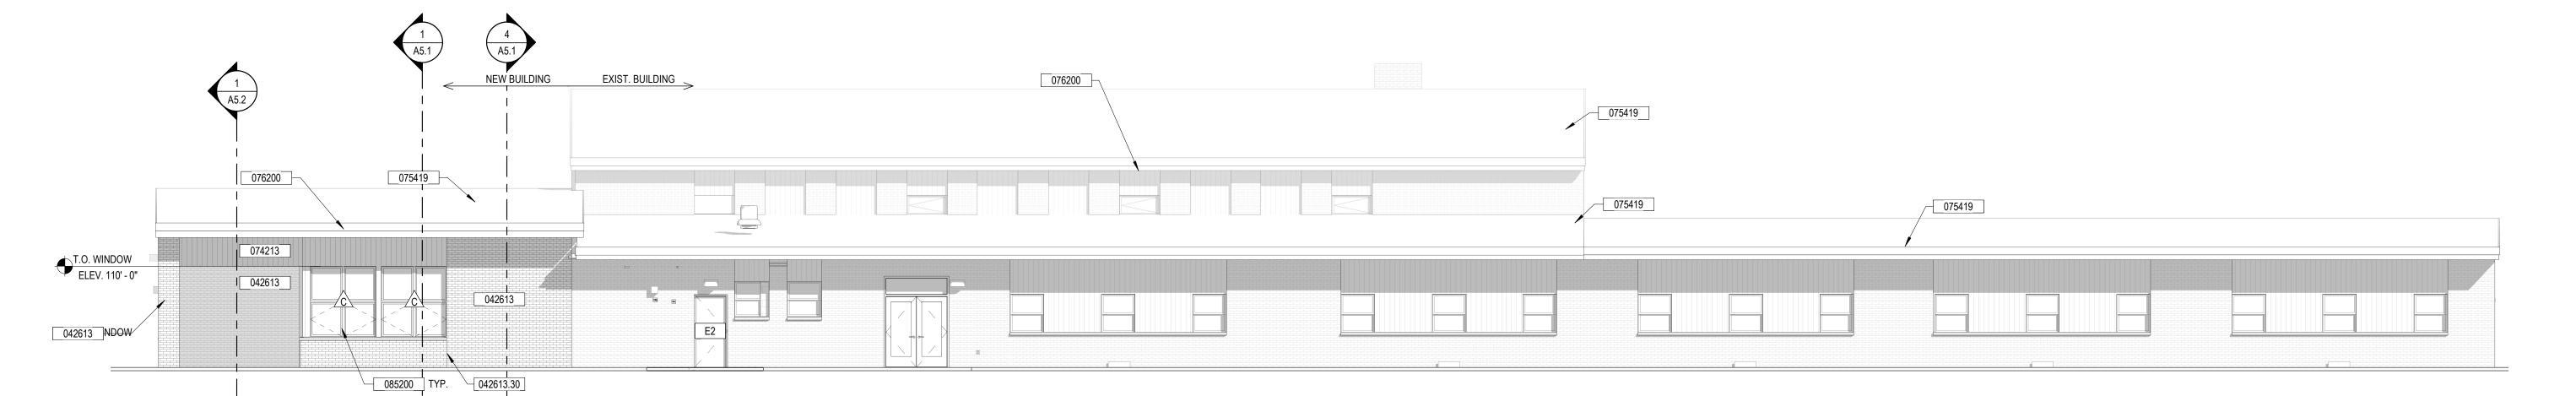

WEST ELEVATION

1/8" ± 1'-0"

SEE A1 SERIES FOR WALL TYPES.

FOR CEILING INFORMATION.

SOFFIT PANELS

GYPSUM BOARD

GYPSUM BOARD - SOFFIT

GYPSUM BOARD - IN-FILL ABOVE ACOUSTICAL PANEL CEILINGS RESILIENT BASE AND ACCESSORIES PLASTIC-LAMINATE-CLAD COUNTERTOPS

**KEYED NOTES** 

ON A1 SERIES.

074293

075419

092900

092900.20

SEE A6 SERIES FOR WALL SECTIONS. SEE A8 SERIES FOR INTERIOR ELEVATIONS.

ROOM FINISH SCHEDULE AND INTERIOR ELEVATIONS.

SEE A10 SERIES FOR DOOR SCHEDULE & WINDOW SCHEDULE.

OWNER FURNISHED OR EXISTING EQUIPMENT PLASTIC-LAMINATE-CLAD ARCHITECTURAL CABINETS

MECHANICAL FIXTURE OR EQUIPMENT - SEE MECHANICAL CONCRETE PAVEMENT - SLOPE AWAY FROM BUILDING

POLYVINYL-CHLORIDE (PVC) ROOFING


ALL EXTERIOR FOUNDATION WALLS BELOW GRADE SHALL BE PROVIDED WITH

Ownership & Use of Documents Drawings and specifications, as instruments of

professional service are and shall remain the property of the architect. These documents are not to be used in whole or in part for any project or purposes whatsoever, without the prior specific written authorization of GPC Architects PLLC.

date: 12/07/2018 BUILDING SECTIONS

A5.1

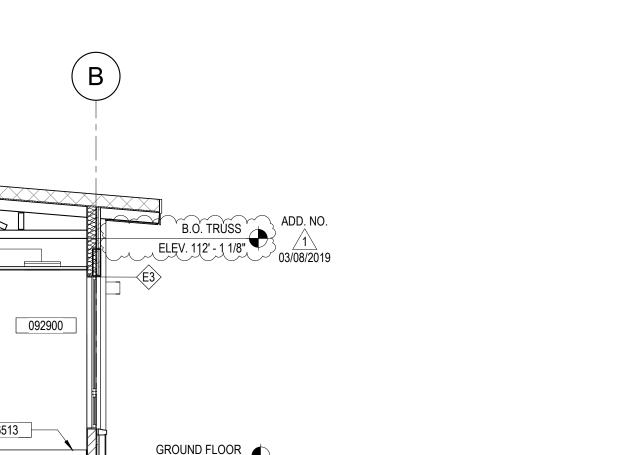

BUILDING SECTION A

3/16" = 1'-0"

095113

123623.13

075419

WORKROOM 127


4 A6.1 A6.1<sub>1</sub>/ 095113 RESOURCE EXISTING CLASSROOM GYMNASIUM 1 (119)

A6.1

064116

A4.2


1 A5.2  $\begin{pmatrix} 4 \\ A5.1 \end{pmatrix}$ 075419 ADD. NO. 03/08/2019 A6.1 075419 230000 T.O. WALL ELEV. 110' - 8" 074293 MECH./MAINT. GROUND FLOOR ELEV.100' - 0"

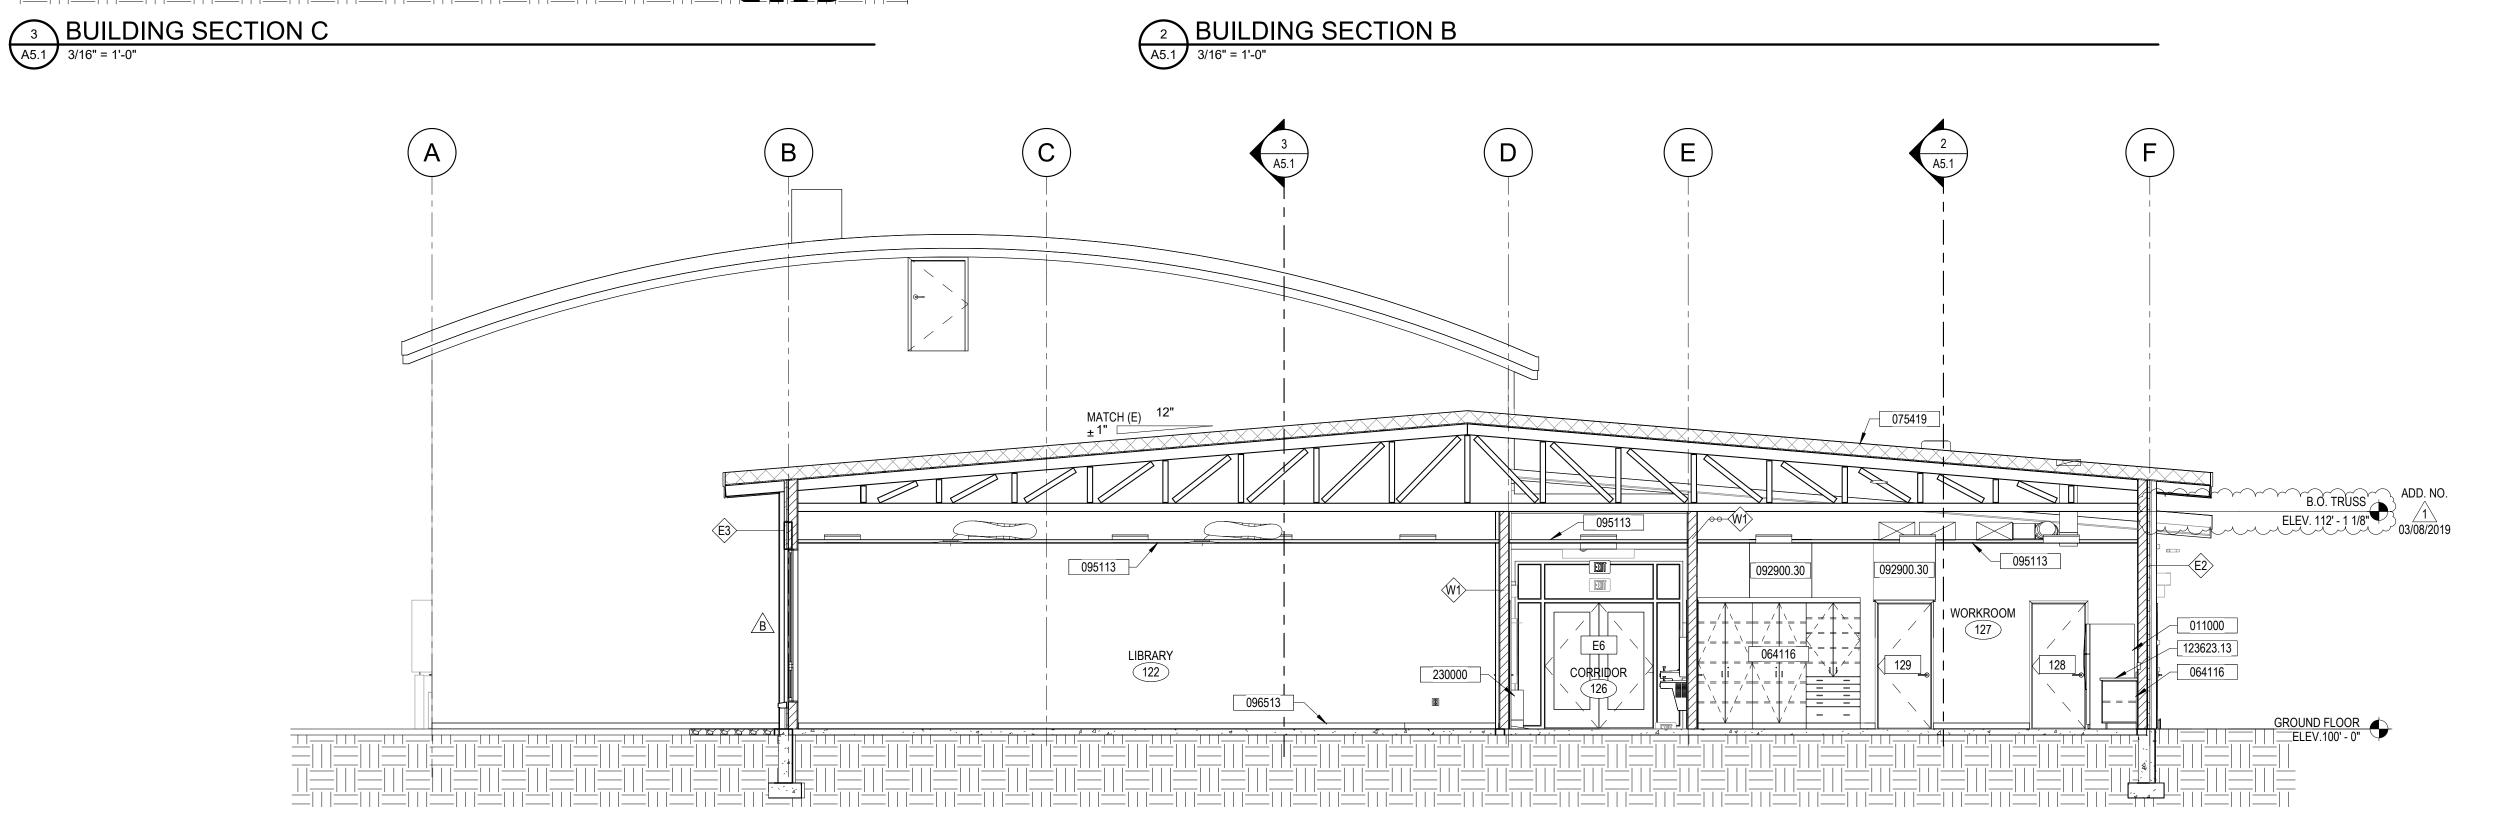

122

A5.1 BUILDING SECTION D

A5.1 3/16" = 1'-0"

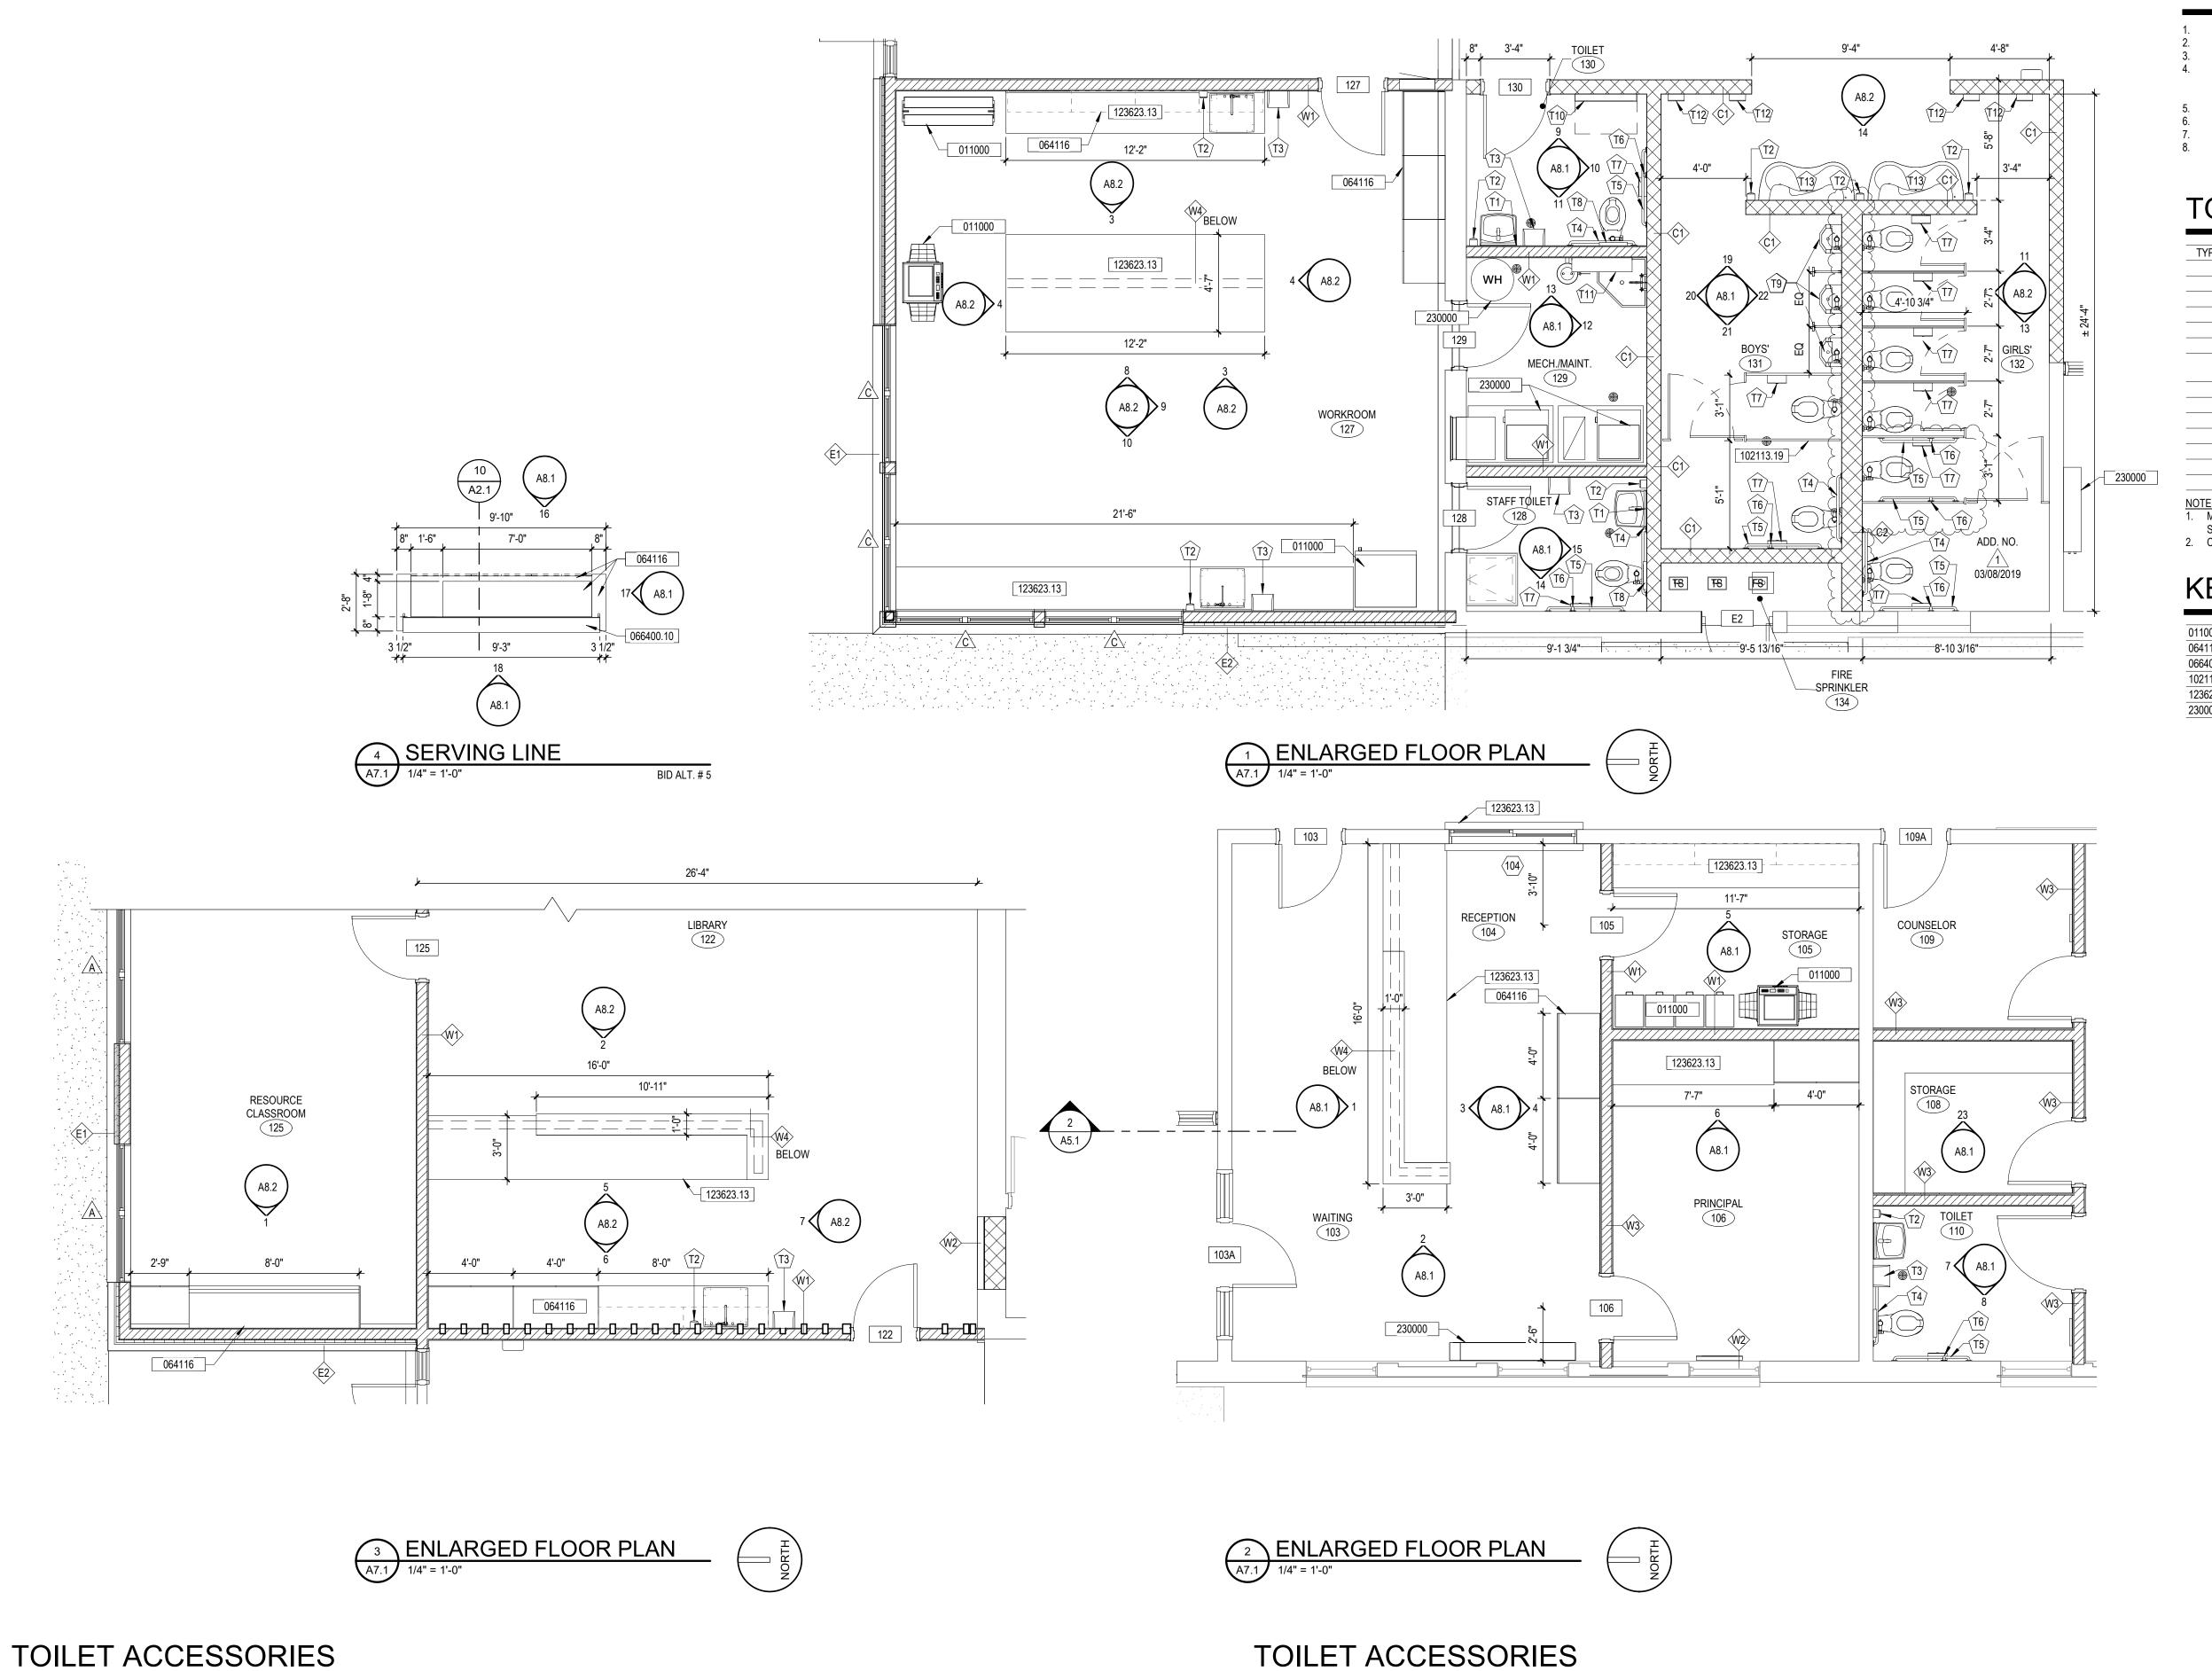

(T8)

### GENERAL NOTES

- SEE A10 SERIES FOR DOOR AND WINDOW SCHEDULES. SEE A11 SERIES FOR REFLECTED CEILING PLANS.
- SEE A2 SERIES FOR FINISH SCHEDULE.
- IF A CONFLICT OR DISCREPANCY OCCURS BETWEEN FLOOR PLANS OF ARCHITECTURAL, STRUCTURAL, MECHANICAL OR ELECTRICAL DRAWINGS, CONTACT ARCHITECT FOR
- CLARIFICATION.
- ALL G.W.B. TO BE TYPE 'X', EXCEPT AS NOTED.
  SEE STRUCTURAL DRAWINGS FOR CONTROL JOINTS IN SLABS.
- PROVIDE CASING BEAD CAULK WHERE G.W.B. ABUTS DISSIMALAR MATERIAL. DIMENSIONS ARE TO FACE OF STUD, FACE OF BLOCK OR GRID LINE UNLESS NOTED

## **TOILET ACCESSORIES**

TYPE MARK	DESCRIPTION	MODEL#
T1	CHANNEL FRAME MIRROR	B-165 2430
T2	SOAP DISPENSER	O.F.C.I.
Т3	TOWEL DISPENSER	O.F.C.I.
T4	STRAIGHT GRAB BAR 36"	B-5806x36
T5	STRAIGHT GRAB BAR 42"	B-5806x42
T6	STRAIGHT GRAB BAR 18"	B-5806x18
T7	SURFACE MOUNTED JUMBO ROLL TOILET TISSUE DISPENSER	O.F.C.I.
T8	SEAT COVER DISPENSER	
Т9	URINAL	SEE MECH.
T10	SURFACE MOUNTED BABY CHANGING STATION	KB200
T11	UTILITY SHELF WITH RAG HOOKS AND BROOM HOLDERS	B-239
T12	AUTOMATIC HAND DRYER - SPEED FLOW PLUS	
T13	LAVATORY SYSTEM	SEE MECH.
T14	DRINKING FOUNTAIN WITH BOTTLE FILLER	SEE MECH.

NOTES:

1. MOST MODEL NUMBERS INDICATED RELATE TO 'BOBRICK' AND ARE USED TO SET MINIMUM

OF THE PROPERTY OF TH STANDARDS UNLESS NOTED OTHERWISE

2. CONTRACTOR TO PROVIDE BLOCKING IN FRAMED WALLS FOR ALL TOILET ACCESSORIES

### **KEYED NOTES**

064116	PLASTIC-LAMINATE-CLAD ARCHITECTURAL CABINETS
066400.10	PLASTIC PANELING - CLEAR SNEEZE GUARD W/ ALUMINUM PIPE SUPPORTS
102113.19	PLASTIC TOILET COMPARTMENTS
123623.13	PLASTIC-LAMINATE-CLAD COUNTERTOPS
230000	MECHANICAL FIXTURE OR EQUIPMENT - SEE MECHANICAL

LICENSED ARCHITECT

AR-984552

GARETT PAUL CHADWICK STATE OF IDAHO

Ownership & Use of Documents

Drawings and specifications, as instruments of

professional service are and shall remain the property


of the architect. These documents are not to be used in whole or in part for any project or purposes whatsoever, without the prior specific written authorization of GPC Architects PLLC.

date: 12/07/2018

**ENLARGED** FLOOR PLANS

A7.1

## TOILET ACCESSORIES MOUNTING HEIGHTS FOR TOILET 110, BOYS 131 & GIRLS 132 ONLY

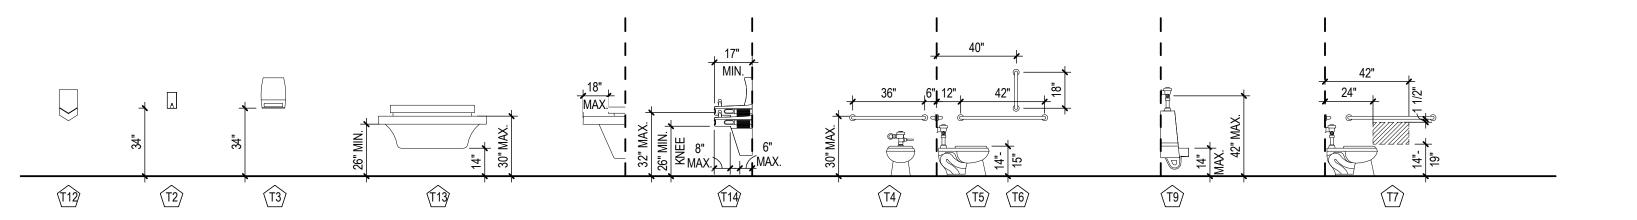


ADULT MOUNTING HEIGHTS

(T5)(T6)

T2

FACE OF WALL, TYP.

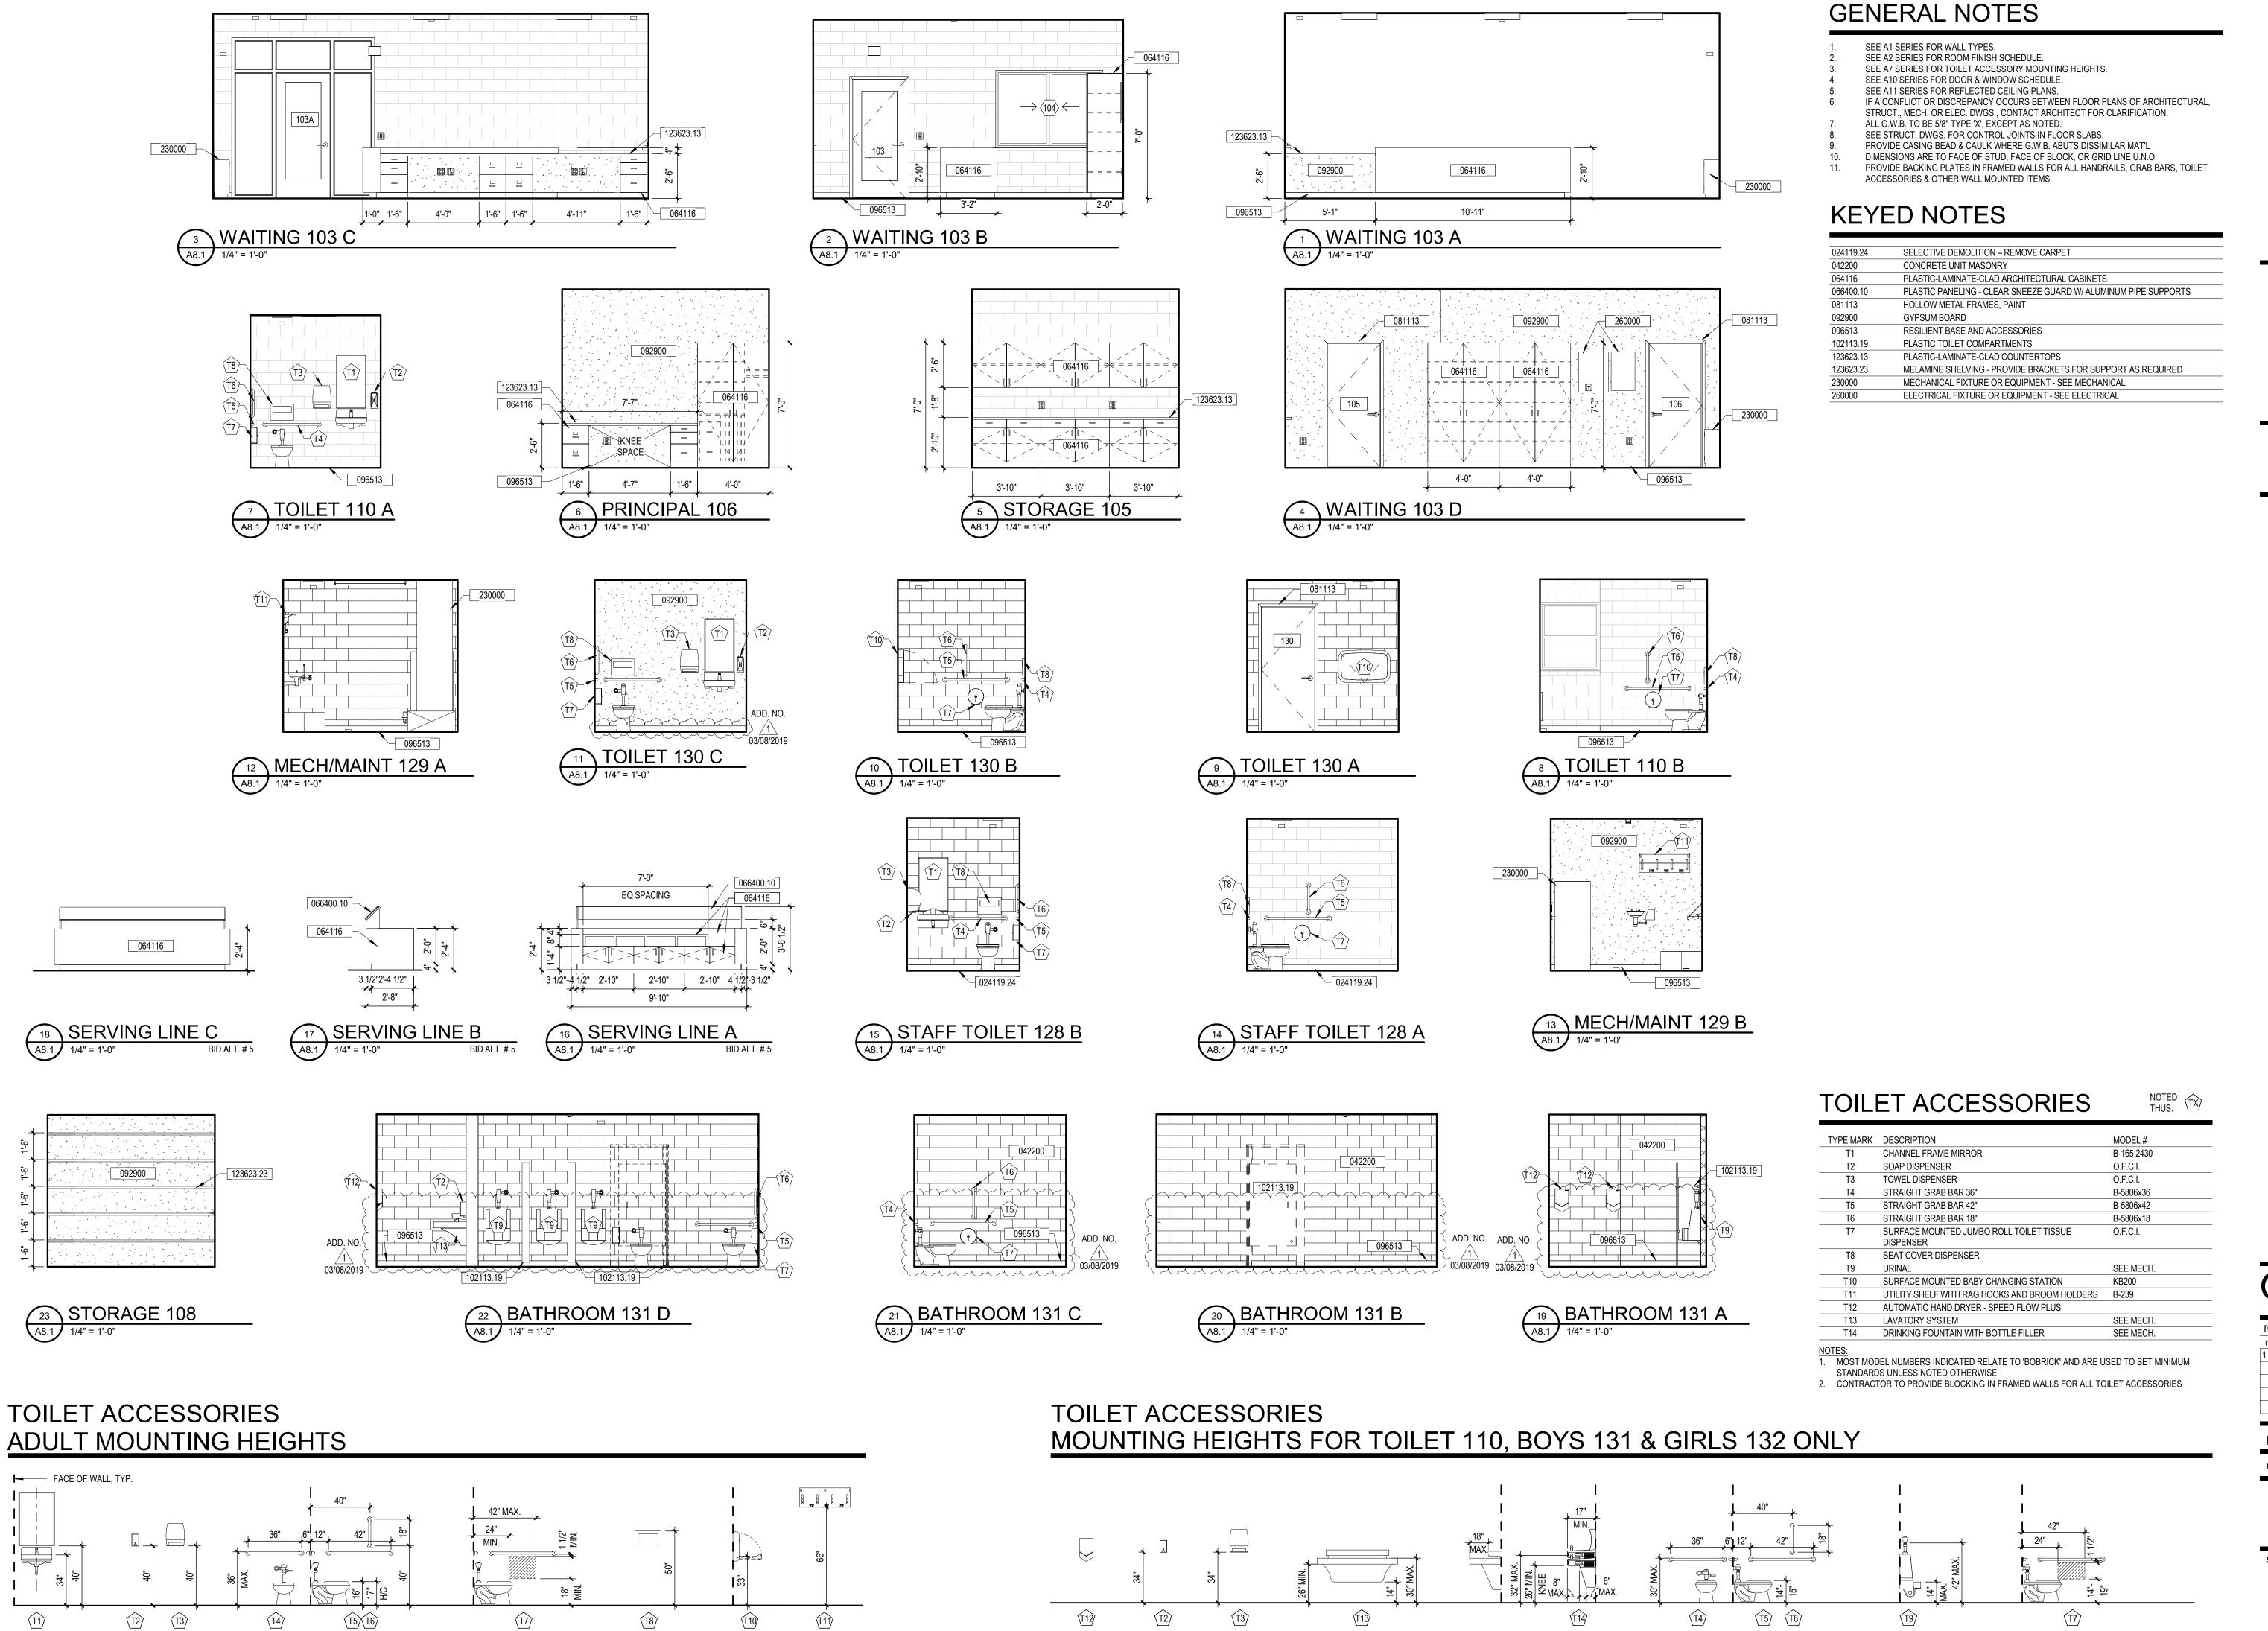


t., Ste. 200 83422

LICENSED

ARCHITECT AR-984552 GARETT PAUL CHADWICK STATE OF IDAHO

Ownership & Use of Documents Drawings and specifications, as instruments of professional service are and shall remain the property

of the architect. These documents are not to be used in whole or in part for any project or purposes whatsoever, without the prior specific written authorization of GPC Architects PLLC.

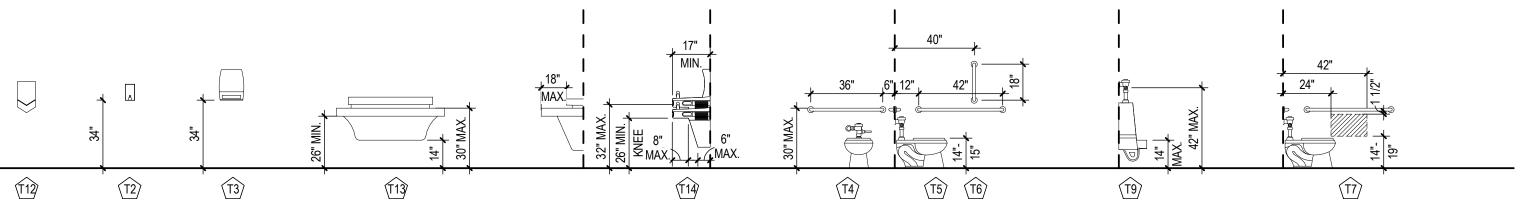


no. description

1724

12/07/2018

INTERIOR **ELEVATIONS** 

A8.1

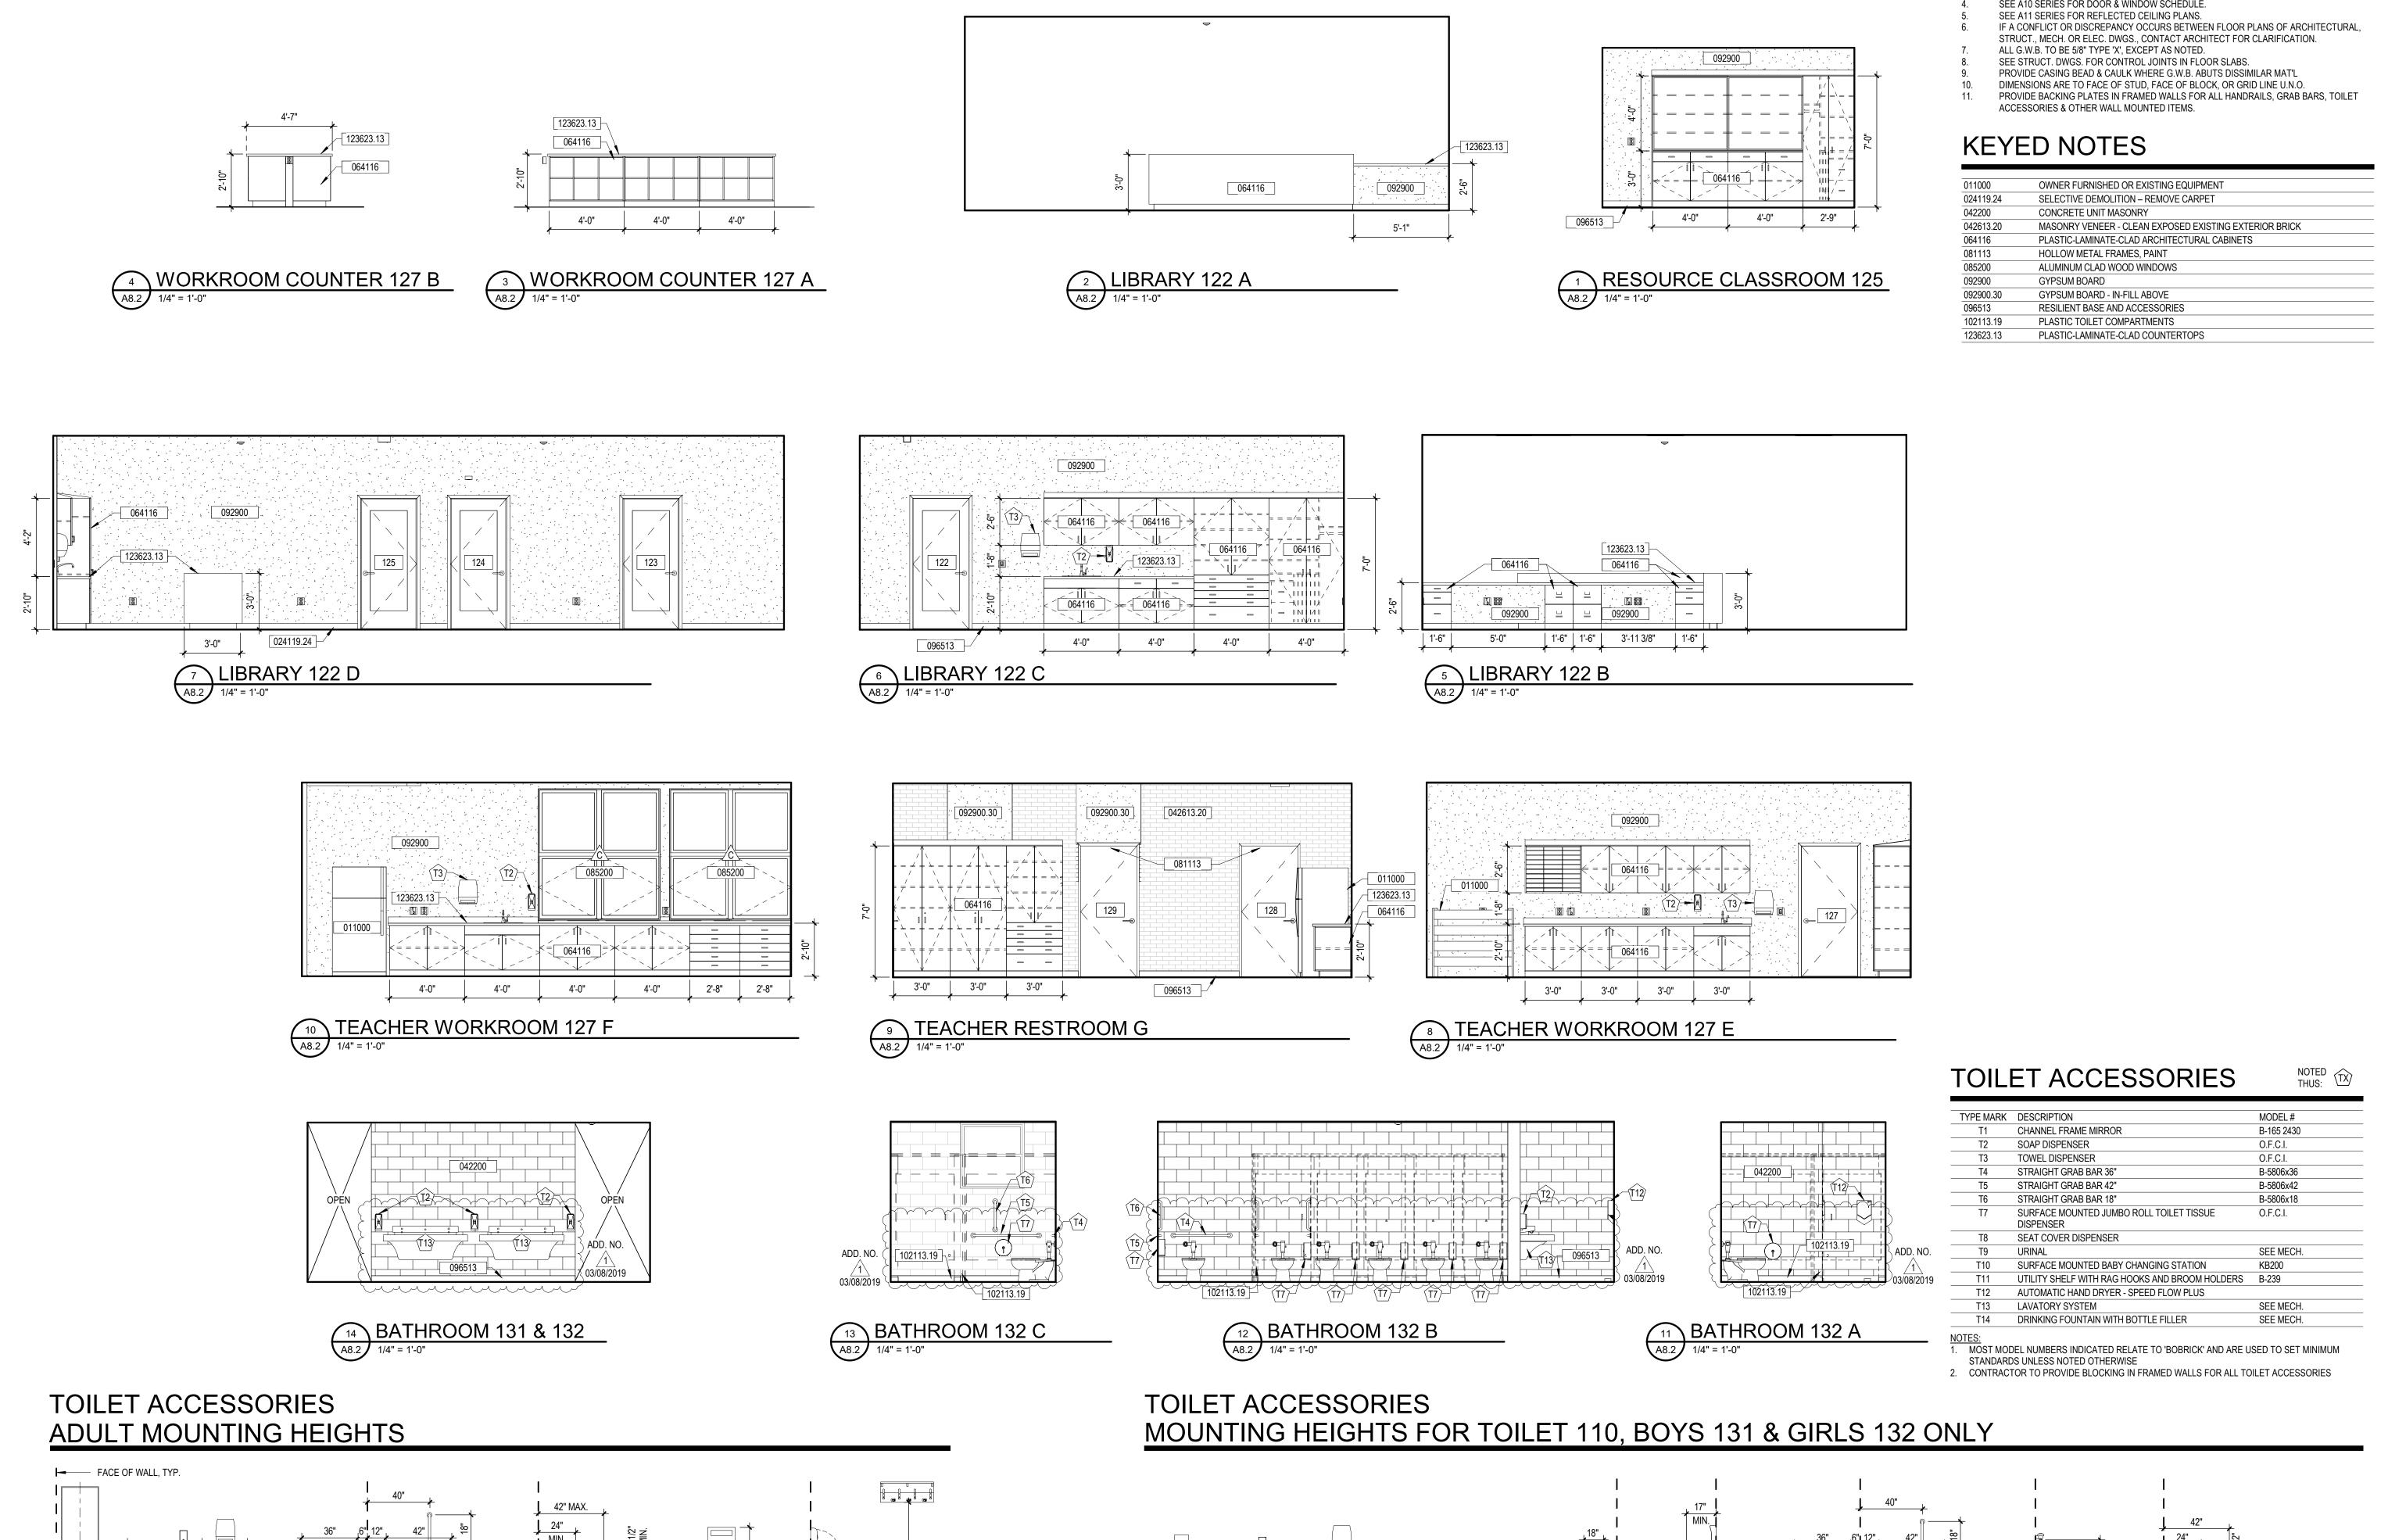

T8)

T5\T6

**GENERAL NOTES** 

SEE A1 SERIES FOR WALL TYPES. SEE A2 SERIES FOR ROOM FINISH SCHEDULE. SEE A7 SERIES FOR TOILET ACCESSORY MOUNTING HEIGHTS.


SEE A10 SERIES FOR DOOR & WINDOW SCHEDULE.

LICENSED ARCHITECT AR-984552 GARETT PAUL CHADWICK STATE OF IDAHO

t., Ste. 200 83422

Ownership & Use of Documents Drawings and specifications, as instruments of in whole or in part for any project or purposes

professional service are and shall remain the property of the architect. These documents are not to be used whatsoever, without the prior specific written authorization of GPC Architects PLLC.

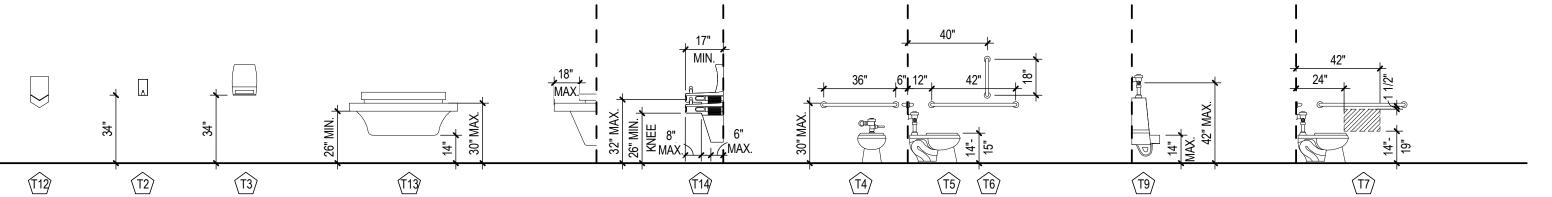


1724 date: 12/07/2018

> INTERIOR **ELEVATIONS**

A8.2

NUMB	ER TYPE	TYPE	DESCRIPTION	WIDTH	HEIGHT	TYPE	DETAIL	DETAIL	DETAIL	REMARKS
EXTER	ΩP					$\sim$				
E1	E E	С	H.M. DOOR FRAME W/ TRANSOM LITE	6' - 0"	7' - 0"	$\overline{\langle 8 \rangle}$	6/A10.3	7/A10.3	1/A10.2	
E2	Α	A	H.M. DOOR & FRAME	3' - 0"	7' - 0"	7- 1	6/A10.3	7/A10.3	1/A10.2	
E3	E	D	H.M. DOOR FRAME W/ SIDE & TRANSOM LITES	6' - 0"	7' - 0"	> 5 \	4/A10.3	5/A10.3	1/A10.2	
E4	Α	Α	H.M. DOOR & FRAME	3' - 0"	± 6' - 8"	(-)	6/A10.3	7/A10.3	1/A10.2	
E5	Α	Α	H.M. DOOR & FRAME	±2'-2"	± 6' - 8"	( - )	6/A10.3	7/A10.3	1/A10.2	
E6	E	E	H.M. DOOR & FRAME W/ SIDE & TRANSOM LITES	6' - 0"	7' - 0"	8 3	6/A10.3	7/A10.3	1/A10.2	
E7	A	Α	H.M. DOOR & FRAME	3' - 0"	5' - 0"	> - }				2
INTERI	OR .					$\langle \cdot \rangle$				
ADD. NO. 101	D	(B)	WOOD DOOR W/ FULL LITE W/ H.M. FRAME W/ SIDE & TRANS	OM LITES ± 6' - 0"	± 7' - 0"	$\overline{\langle 3 \rangle}$	6/A10.2	7/A10.2	-	
103	D	A	WOOD DOOR W/ FULL LITE W/ H.M. FRAME	3' - 0"	6' - 8"	3 3	8/A10.2	9/A10.2	-	
3/08/2019 103/	. D	(F)	WOOD DOOR W/ FULL LITE W/ H.M. FRAME W/ SIDE & TRANS	OM LITES 3' - 0"	7' - 0"	> 3 {	8/A10.2	9/A10.2		
105	В	Ā	WOOD DOOR W/ H.M. FRAME	3' - 0"	7' - 0"	\ - \	2/A10.2	3/A10.2	-	
106	В	Α	WOOD DOOR W/ H.M. FRAME	3' - 0"	7' - 0"	( - )	2/A10.2	3/A10.2	-	
107	С	Α	WOOD DOOR W/ VIEW LITE W/ H.M. FRAME	3' - 6"	6' - 8"	£ 2 \	2/A10.2	3/A10.2		
108	В	Α	WOOD DOOR W/ H.M. FRAME	± 3' - 0"	± 7' - 0"	> - {	2/A10.2	3/A10.2	-	
109	С	Α	WOOD DOOR W/ VIEW LITE W/ H.M. FRAME	3' - 0"	7' - 0"	2 >	2/A10.2	3/A10.2	-	1
109/	C	Α	WOOD DOOR W/ VIEW LITE W/ H.M. FRAME	3' - 0"	6' - 8"	(2)	2/A10.2	9/A10.2	-	
110	В	Α	WOOD DOOR WITH HOLLOW METAL FRAME	± 3' - 6"	± 7' - 0"	> - 3	8/A10.2	3/A10.2	_	1
111	С	Α	WOOD DOOR W/ VIEW LITE W/ H.M. FRAME	± 3' - 6"	± 6' - 8"	2 3	2/A10.2	3/A10.2		
112	С	Α	WOOD DOOR W/ VIEW LITE W/ H.M. FRAME	± 3' - 0"	± 6' - 8"	<b>2</b> ?	8/A10.2	9/A10.2	-	
113	С	Α	WOOD DOOR W/ VIEW LITE W/ H.M. FRAME	± 3' - 0"	± 6' - 8"	(2)	8/A10.2	9/A10.2	-	
114	С	Α	WOOD DOOR W/ VIEW LITE W/ H.M. FRAME	± 3' - 0"	± 6' - 8"	> 2 \	8/A10.2	9/A10.2	-	
115	С	Α	WOOD DOOR W/ VIEW LITE W/ H.M. FRAME	± 3' - 0"	± 6' - 8"	₹ 2 ₹	8/A10.2	9/A10.2	-	
116	С	Α	WOOD DOOR W/ VIEW LITE W/ H.M. FRAME	± 3' - 0"	± 6' - 8"	<b>√</b> 2 √	8/A10.2	9/A10.2	ADD. NO.—	
117	С	Α	WOOD DOOR W/ VIEW LITE W/ H.M. FRAME	± 3' - 0"	± 6' - 8"	(2)	8/A10.2	9/A10.2		
118	F	-	OPERABLE WALL	24' - 7"	9' - 9"	> - }	8/A10.3	9/A10.3	3/08/2019	
119	С	Α	DBL. WOOD DOOR W/ VIEW LITES W/ H.M. FRAME	ADD. NO. (±)5' - 0"	(±)6' - 8"	2	8/A)0.2	9/A,10.2	3/06/2019	
122	D	Α	WOOD DOOR W/ FULL LITE W/ H.M. FRAME	1 3' - 0"	7' - 0"	(3)	2/A10.2	3/A10.2	-	
123	D	Α	WOOD DOOR W/ FULL LITE W/ H.M. FRAME	03/08/2019 3' - 0"	7' - 0"	<b>₹</b> 3 ₹	2/A10.2	3/A10.2	-	
124	D	А	WOOD DOOR W/ FULL LITE W/ H.M. FRAME	3' - 0"	7' - 0"	> 3 \	2/A10.2	3/A10.2	-	
125	D	А	WOOD DOOR W/ FULL LITE W/ H.M. FRAME	3' - 0"	7' - 0"	3 ₹	2/A10.2	3/A10.2	SIM	
127	С	Α	WOOD DOOR W/ H.M. FRAME	3' - 0"	7' - 0"	2 }	2/A10.2	3/A10.2	-	
128	В	А	WOOD DOOR W/ H.M. FRAME	3' - 0"	7' - 0"	>->	8/A10.2	9/A10.2	-	1
129	В	Α	WOOD DOOR W/ H.M. FRAME	3' - 0"	7' - 0"	\ - \	2/A10.2	9/A10.2	-	
130	В	A	WOOD DOOR W/ H.M. FRAME	3' - 0"	7' - 0"	( _ \	10/A10.2	11/A10.2	-	1

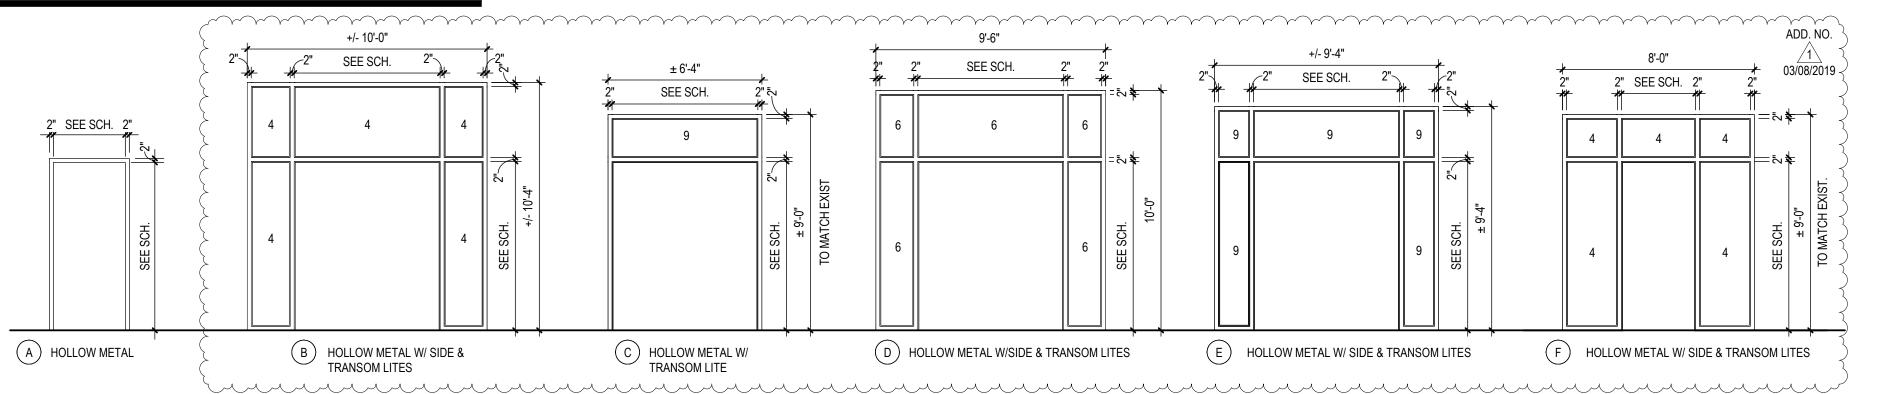

archite 18 N. Main St., Ste. 200 Driggs, Idaho 83422 208.354.8036 www.gpcarchitects.com

LICENSED ARCHITECT AR-984552





Ownership & Use of Documents Drawings and specifications, as instruments of professional service are and shall remain the property of the architect. These documents are not to be used in whole or in part for any project or purposes whatsoever, without the prior specific written authorization of GPC Architects PLLC.

date: 12/07/2018


WINDOW & DOOR SCHEDULES

A10.1

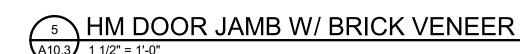


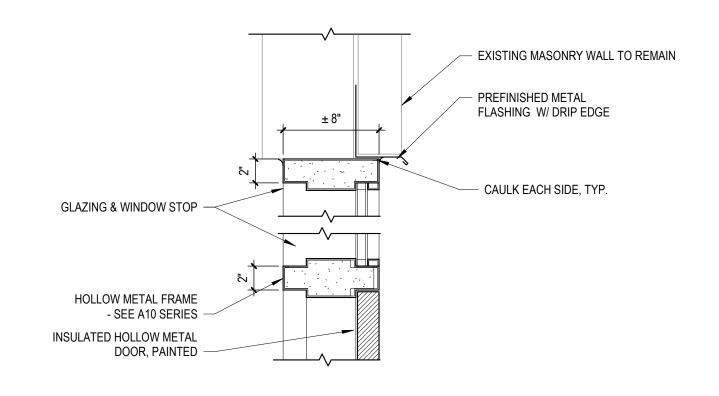


#### 6 HM DOOR & TRANSOM HEAD @ (E) WALL A10.3 1 1/2" = 1'-0"

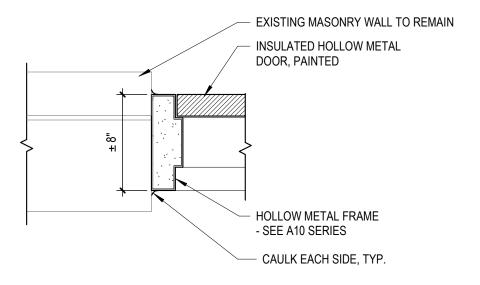


## THM DOOR & TRANSOM JAMB @ (E) WALL

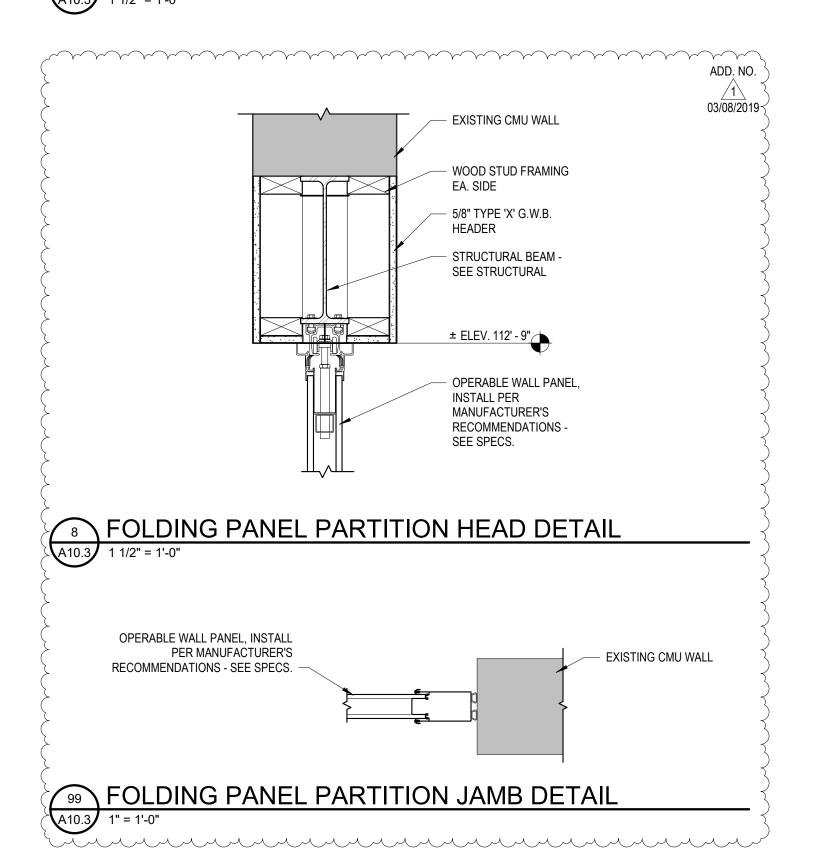


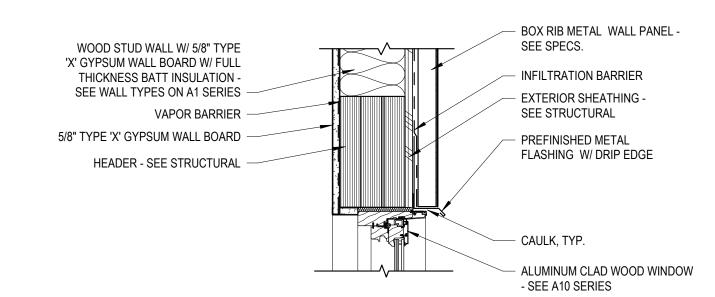


1 ALUM. CLAD WOOD HEAD

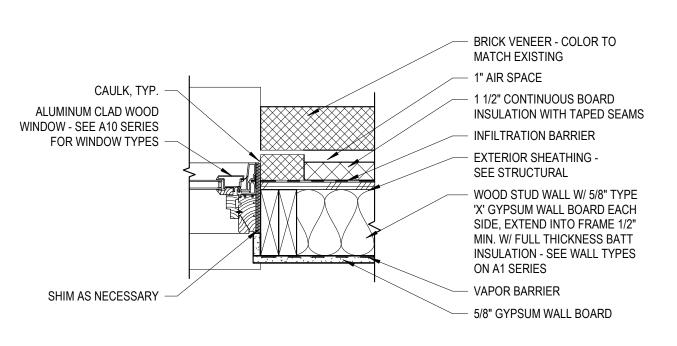

2 ALUM. CLAD WOOD JAMB A10.3 1 1/2" = 1'-0"

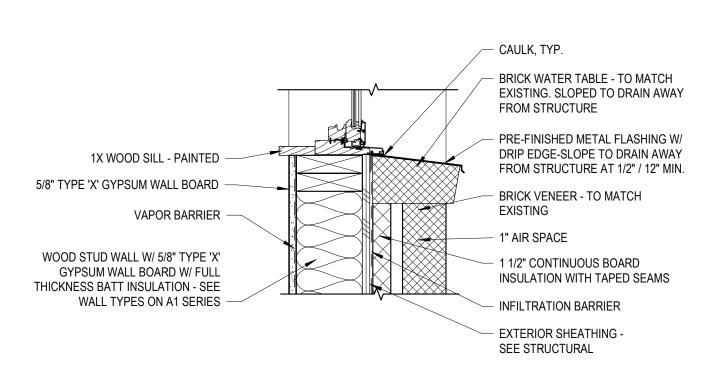

ALUM. CLAD WOOD SILL

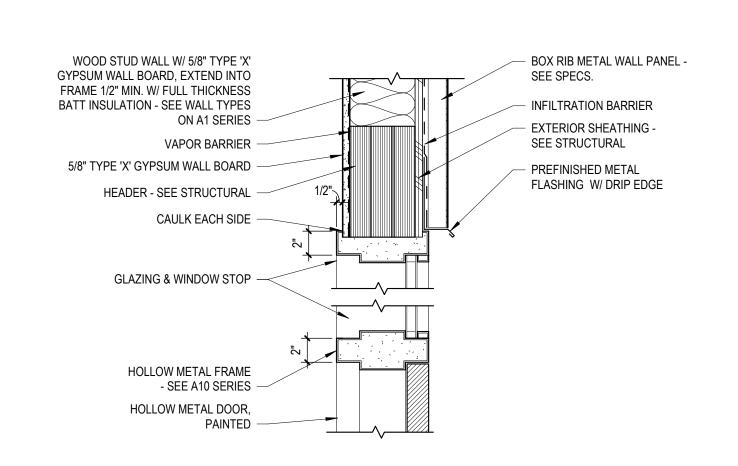

HM DOOR & TRANSOM HEAD

of the architect. These documents are not to be used in whole or in part for any project or purposes whatsoever, without the prior specific written authorization of GPC Architects PLLC.

LICENSED ARCHITECT AR-984552

GARETT PAUL CHADWICK

STATE OF IDAHO

Ownership & Use of Documents

Drawings and specifications, as instruments of

professional service are and shall remain the property

no. description

1724 date: 12/07/2018

> WINDOW AND DOOR DETAILS

A10.3

**CEILING TYPES** 

C1 PAINTED, TEXTURED TYPE 'X' GYPSUM WALL BOARD

**CEILING LEGEND** 

○ RECESSED CAN (EXT. OR INT) 

STRIP LIGHT

### GENERAL NOTES

**KEYED NOTES** 

CENTER LIGHT FIXTURES, ETC., IN CEILING TILES OR AS SHOWN. SHEATHING - PLYWOOD DECKED PLANKING SYSTEM INSTALLED TO BOTTOM CORD LIGHT FIXTURES WHICH OCCUR IN GWB CEILINGS ARE TO BE CENTERED BETWEEN OF GYM TRUSSES FIRE SUPRESSION ACCESS FOR MAINTENANCE & FUTURE ADD. NO. WALLS AND/OR CASEWORK, UNLESS OTHERWISE NOTED. REFER TO FLOOR PLANS, A1



.., Ste. 2 83422

archite

Ownership & Use of Documents

Drawings and specifications, as instruments of professional service are and shall remain the property of the architect. These documents are not to be used in whole or in part for any project or purposes whatsoever, without the prior specific written authorization of GPC Architects PLLC.

A3.1

SCH

no. description

project: 1724 12/07/2018

REFLECTED **CEILING PLAN** 

A11.1




Ownership & Use of Documents

Drawings and specifications, as instruments of professional service are and shall remain the property of the architect. These documents are not to be used in whole or in part for any project or purposes whatsoever, without the prior specific written authorization of GPC Architects PLLC.

date: 12/07/2018

FOUNDATION PLAN

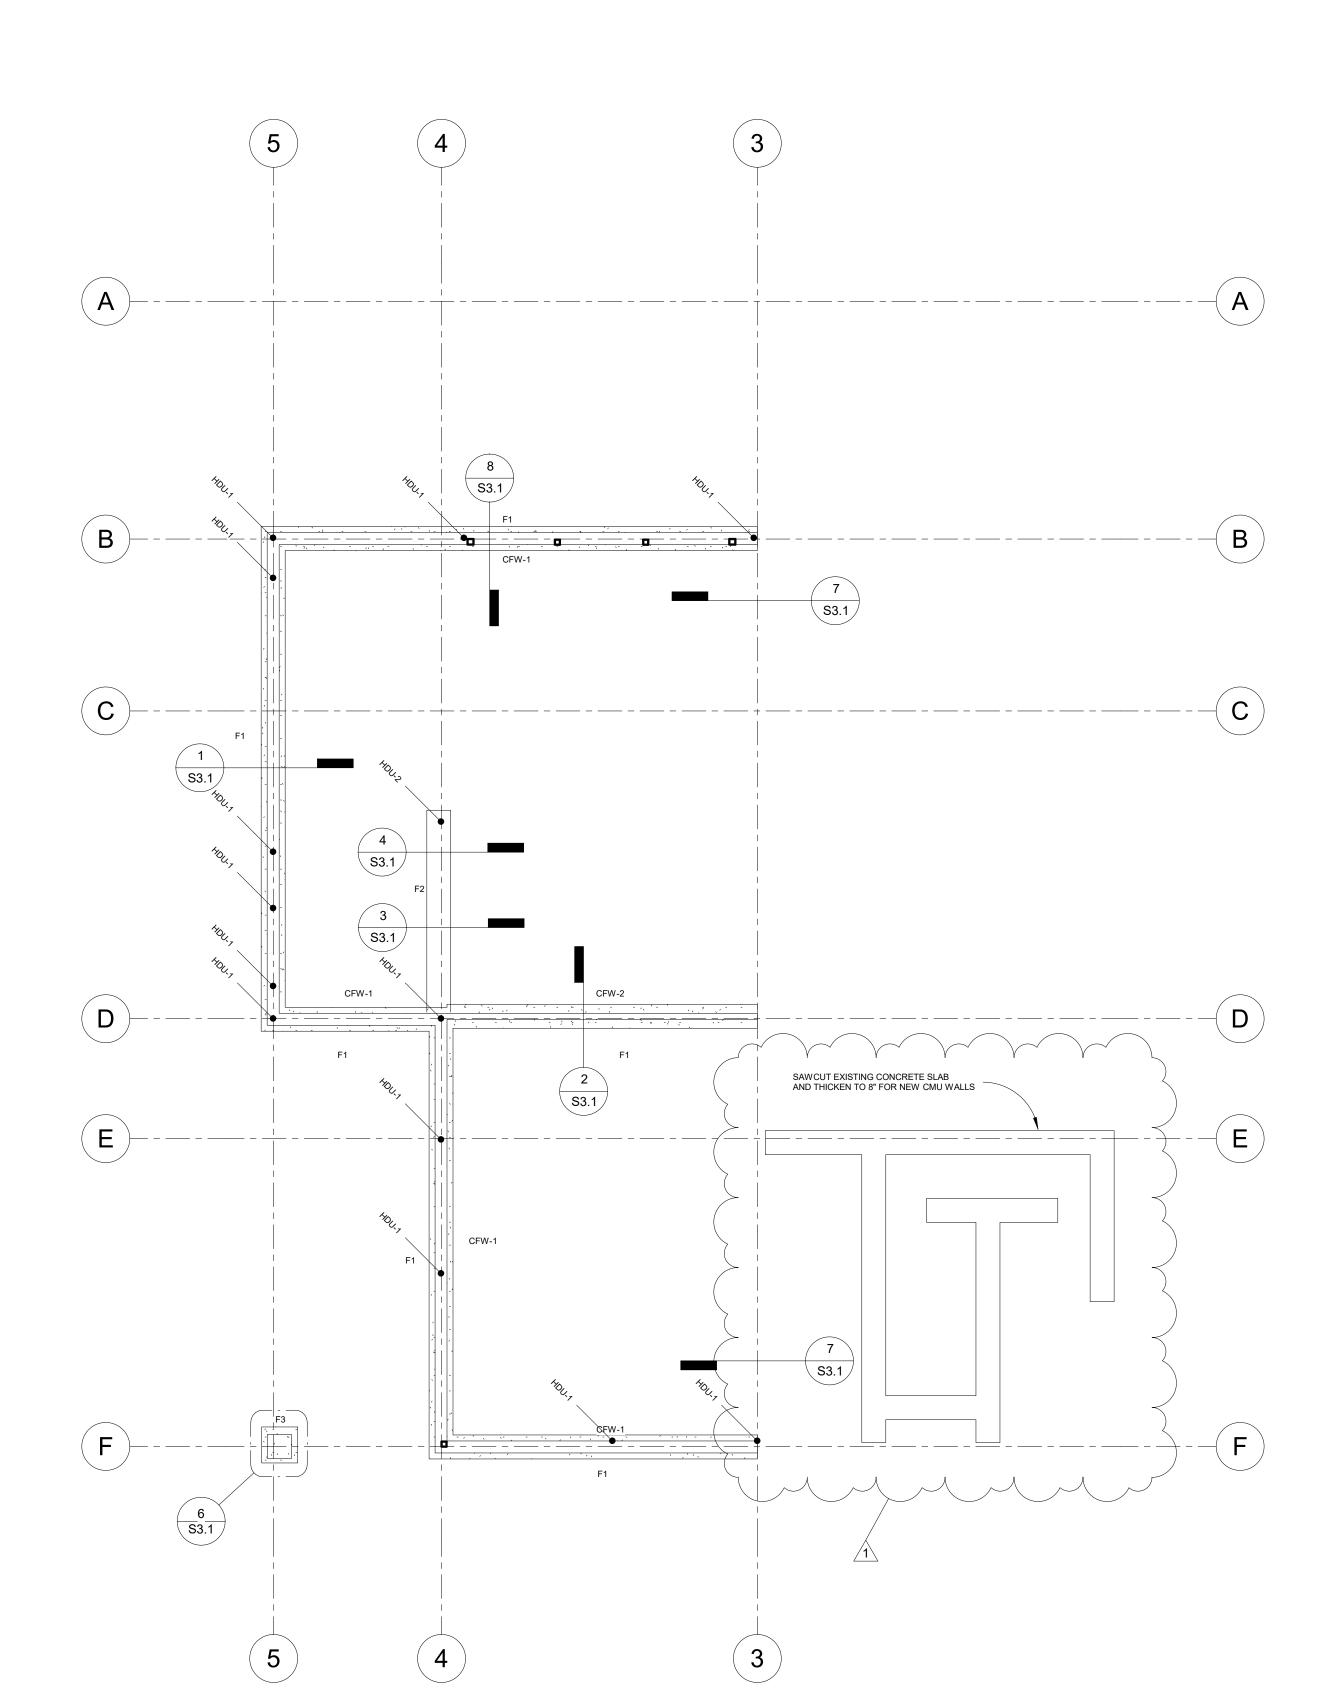

1 FOUNDATION PLAN
1/8" = 1'-0"

	FOOTING SCHEDULE													
MARK WIDTH LENGTH DEPTH REINF. CROSSWISE REIN							NF. LEI	NGTHWISE						
MARK	WIDTH	LENGTH	DEPIN	NO.	SIZE	LENGTH	NO.	SIZE	LENGTH					
F1	2'-0"	CONT.	10"	-	-	-	3	#4	CONT. AS SHOWN					
F2	2'-0"	CONT.	12"	-	-	-	3	#4	CONT. AS SHOWN	THICKENED SLAB				
F3	3'-0"	3'-0"	10"	3	#4	2'-6"	3	#4	2'-6"					

	CONCRETE FOUNDATION WALL SCHEDULE												
MARK	THICKNESS	HORIZONTAL REINFORCING	VERTICAL REINFORCING	HORIZONTAL BARS	# OF MATS								
CFW - 1	1' - 0"	#4 @ 12" O.C.	#4 @ 18" O.C.	2 - #5	2								
CFW - 2	0' - 6"	#5 @ 12" O.C.	#5 @ 18" O.C.	1 - #5	1								

NOTE: SEE ARCH FOR ALL DIMENSIONS.

WSW-# - ALL SHEAR WALLS TO BE PER SHEAR WALL SCHEDULE ON SHEET S1.2 HDU-1 - SIMPSON HDU4-SDS2.5 W/ 5/8" DIA. SIMPSON SSTB24 ANCHOR BOLTS

HDU-2 - SIMPSON HDU4-SDS2.5 W/ 5/8" DIA. 12" LONG HEADED BOLT



no.descriptiondate1Addendum #103.08.19


project: 1724 date: 12/07/2018

ROOF FRAMING PLAN

S2.2

SNOW DRIFT SCHEDULE DRIFT LOAD (PSF) DRIFT LENGTH SND-1 20' - 0" 134.00 lb/ft<sup>2</sup>

	MASONRY BEAM SCHEDULE												
BEAM	DIM	ENSION											
	WIDTH	LENGTH	DEPTH	QTY.	BAR SIZE	SPACING	LENGTH						
MB1	8"	10'	48"	2	NO. 5	TOP & BOTTOM	18' MIN						
MB2	8"	3'-0"	40"	2	NO. 5	BOTTOM	8' MIN						

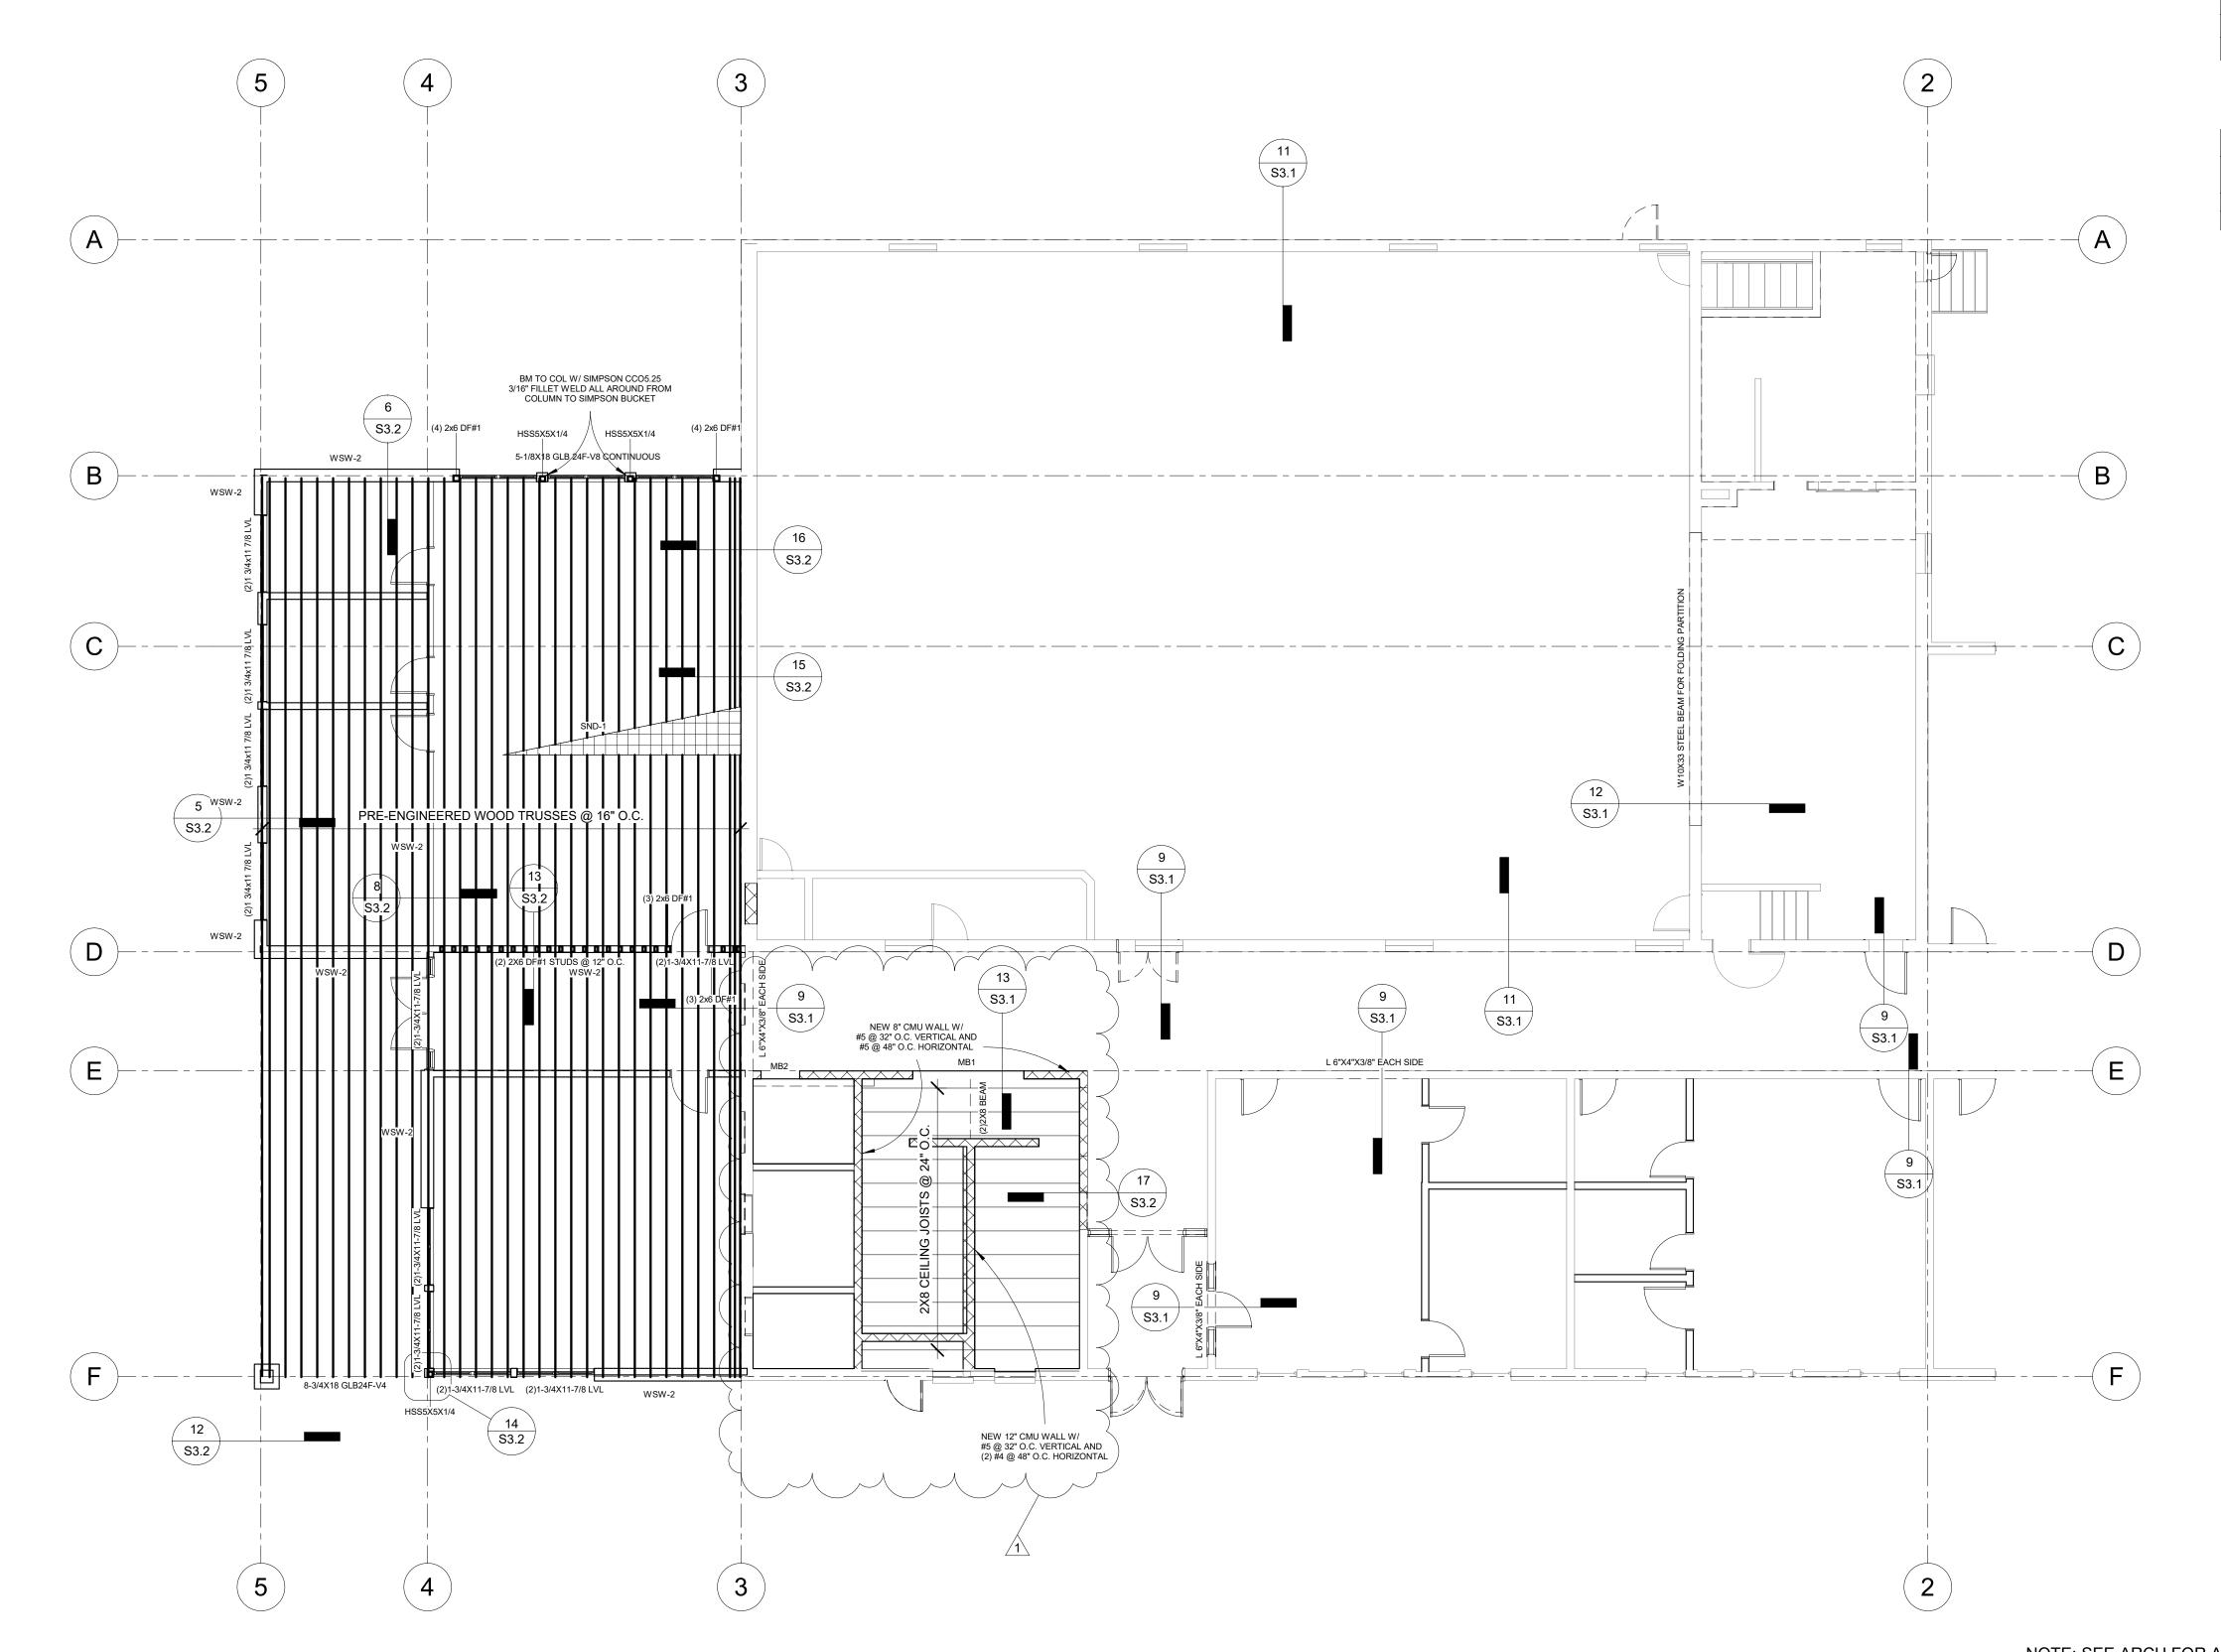

1) ROOF FRAMING PLAN 1/8" = 1'-0"

NOTE: SEE ARCH FOR ALL DIMENSIONS.

WSW-# - ALL SHEAR WALLS TO BE PER SHEAR WALL SCHEDULE ON SHEET S1.2 ROOF SHEATHING: USE 3/4" APA RATED SHEATHING W/ 10d NAILS @ 6" O.C. ALL PANEL EDGES & BLOCKING, AND 12" O.C. IN THE FIELD.

PAGING/BELL SYSTEM SCHEDULE				
ID	DESCRIPTION	MANUFACTURER	MODEL	NOTES
EILING SPEAKER				
CR1	CEILING MOUNTED SPEAKER W/ RECESSED BACKBOX & MOUNTING	TELECOR	STB-10	
	HARDWARE FOR LAY-IN CEILING TYPE			
CR2	CEILING MOUNTED SPEAKER W/ SURFACE BACKBOX	TELECOR	STB-10	
ALL SPEAKER				

TELECOR AP-15T

#### PAGING/BELL SYSTEM NOTES:

WS1 OUTDOOR HORN/LOUDSPEAKER W/ REQUIRED BACKBOX

- A. PROVIDE ALL THE EQUIPMENT, MATERIALS AND LABOR NECESSARY TO EXPAND THE EXISTING TELECOR XL PAGING SYSTEM. THE SYSTEM ADDITION SHALL BE CONNECTED DIRECTLY TO THE EXISITNG PAGING HEAD-END EQUIPMENT. THE INSTALLATION SHALL BE AS RECOMMENDED BY THE MANUFACTURER.
- WHEN THE SYSTEM IS COMPLETE, A FACTORY REPRESENTATIVE SHALL TEST THE SYSTEM, MAKE ADJUSTMENTS AND PLACE THE SYSTEM IN OPERATING ORDER.
- WITHIN 20 DAYS AFTER THE CONTRACT AWARD AND PRIOR TO THE PURCHASE OF ANY EQUIPMENT, THE SYSTEM CONTRACTOR SHALL SUMBIT FOR APPROVAL A DIGITAL PDF DOCUMENT OF THE FOLLOWING:
- 1. A LIST OF MATERIALS THAT ARE TO BE USED ON THE PROJECT, INCLUDING MANUFACTURER, MODEL NUMBERS AND TECHINCAL INFORMATION.
- PRELININARY CIRCUIT DIAGRAMS SHOWING INTERCONNECTION OF ALL DEVICES AND MODULES.
   TECHINCAL MANUALS FOR ALL OF THE EQUIPMENT THAT IS TO BE USED ON THE PROJECT.
- D. CONTRACTOR SHALL PROVIDE AND INSTALL ALL REQUIRED POWER SUPPLIES, ELECTRONICS, BACKBOXES, EXPANSION CARDS, CONNECTIONS AND ETC. REQUIRED TO MODIFY THE EXISTING SYSTEM TO ACCEPT THE NEW DEVICES.
- E. FOR BIDDING OF THE PAGING SYSTEM CONACT:
- AEI GROUP
- KEN THOMPSON 208-888-2331

#### **GENERAL NOTES:**

A. REFER TO SYMBOL SCHEDULES FOR GENERAL NOTES
ASSOCIATED WITH THE INSTALLATION OF EACH SYSTEM; LIGHTING,
POWER, FIRE ALARM, SPECIAL SYSTEMS, ETC.

IN NEW CONSTRUCTION AND REMODEL AREAS ALL CIRCUITING, LOW VOLTAGE CABLING, FIRE ALARM CABLING AND ETC. SHALL BE CONCEALED IN WALLS, FLOORS, CEILINGS, ETC. IN REMODEL AREAS WHERE CABLING/WIRING CANNOT BE CONCEALED IT SHALL BE INSTALLED IN WIREMOLD IN ALL FINISHED AREAS. RACEWAY SHALL BE ROUTED IN A PROFESSIONAL MANNER AT 90 DEG. ANGLES TO STRUCTURES. INSTALL RACEWAY IN LOCATIONS TO MINIMIZE VISUAL APPEARANCE AS MUCH AS POSSIBLE.

SPECIAL NOTES:

- ALL EXPOSED RACEWAY SHALL BE PAINTED TO MATCH EXISTING SURFACE IN WHICH IT IS INSTALLED.
- UTILIZING SURFACE MOUNTED RACEWAY OR DEVICES IN FINISHED AREAS OF NEW ADDITION IS PROHIBITED.

#### KEY NOTES:

- NEW LOCATION OF RELOCATED PA SPEAKER; RE-INSTALL AS REQUIRED TO MAINTAIN ORIGINAL FUNCTIONALITY.
- 2 CAT 6 CABLE TO PAGING SYSTEM HEAD-END EQUIPMENT. ROUTE CABLING IN ACCESSIBLE CEILING OF ADDITION AND THROUGH PIPE TUNNELS OF EXISTING BUILDING.
- TUNNELS OF EXISTING BUILDING.

  PROVIDE AND INSTALL NEW STATION CARD IN EXISTING TELECOR
  EQUIPMENT AS REQUIRED FOR ADDITIONAL SPEAKERS AND ZONES.

  PROVIDE ADDITIONAL PATCH PANELS AND ETC. AS REQUIRED TO
- PROVIDE ADDITIONAL PATCH PANELS AND ETC. AS REQUIRED TO EXISTING RACK TO ACCOMIDATE NEW TELE/DATA CABLING INDICATED.


  PROVIDE 120V POWER FOR ACCESS CONTROL SYSTEM
- CONTROLLER (BY OWNER). FIELD COORDINATE EXACT LOCATION OF CONTROLLER WITH OWNER'S SECURITY SYSTEM CONTRACTOR

  REPORTOR COUNTROLLER WITH OWNER SYSTEM CONTRACTOR

  5 DATA OUTLET FOR EXTERIOR WIRELESS ACCESS POINT, FIELD VERIFY MOUNTING HEIGHT WITH OWNER PRIOR TO ROUGH-IN.

  UTILIZE DATA OUTLET AND BOX RATED FOR EXTERIOR USE,


  PANDUIT CFPWR4CIG OR EQUAL.

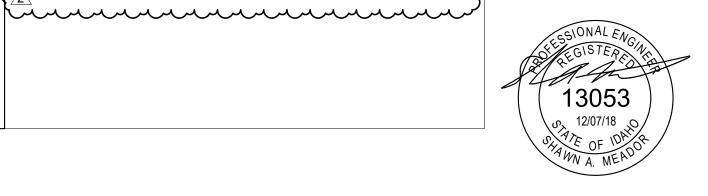

+-

archite

Ownership & Use of Documents
Drawings and specifications, as instruments of
professional service are and shall remain the property
of the architect. These documents are not to be used
in whole or in part for any project or purposes
whatsoever, without the prior specific written
authorization of GPC Architects PLLC.

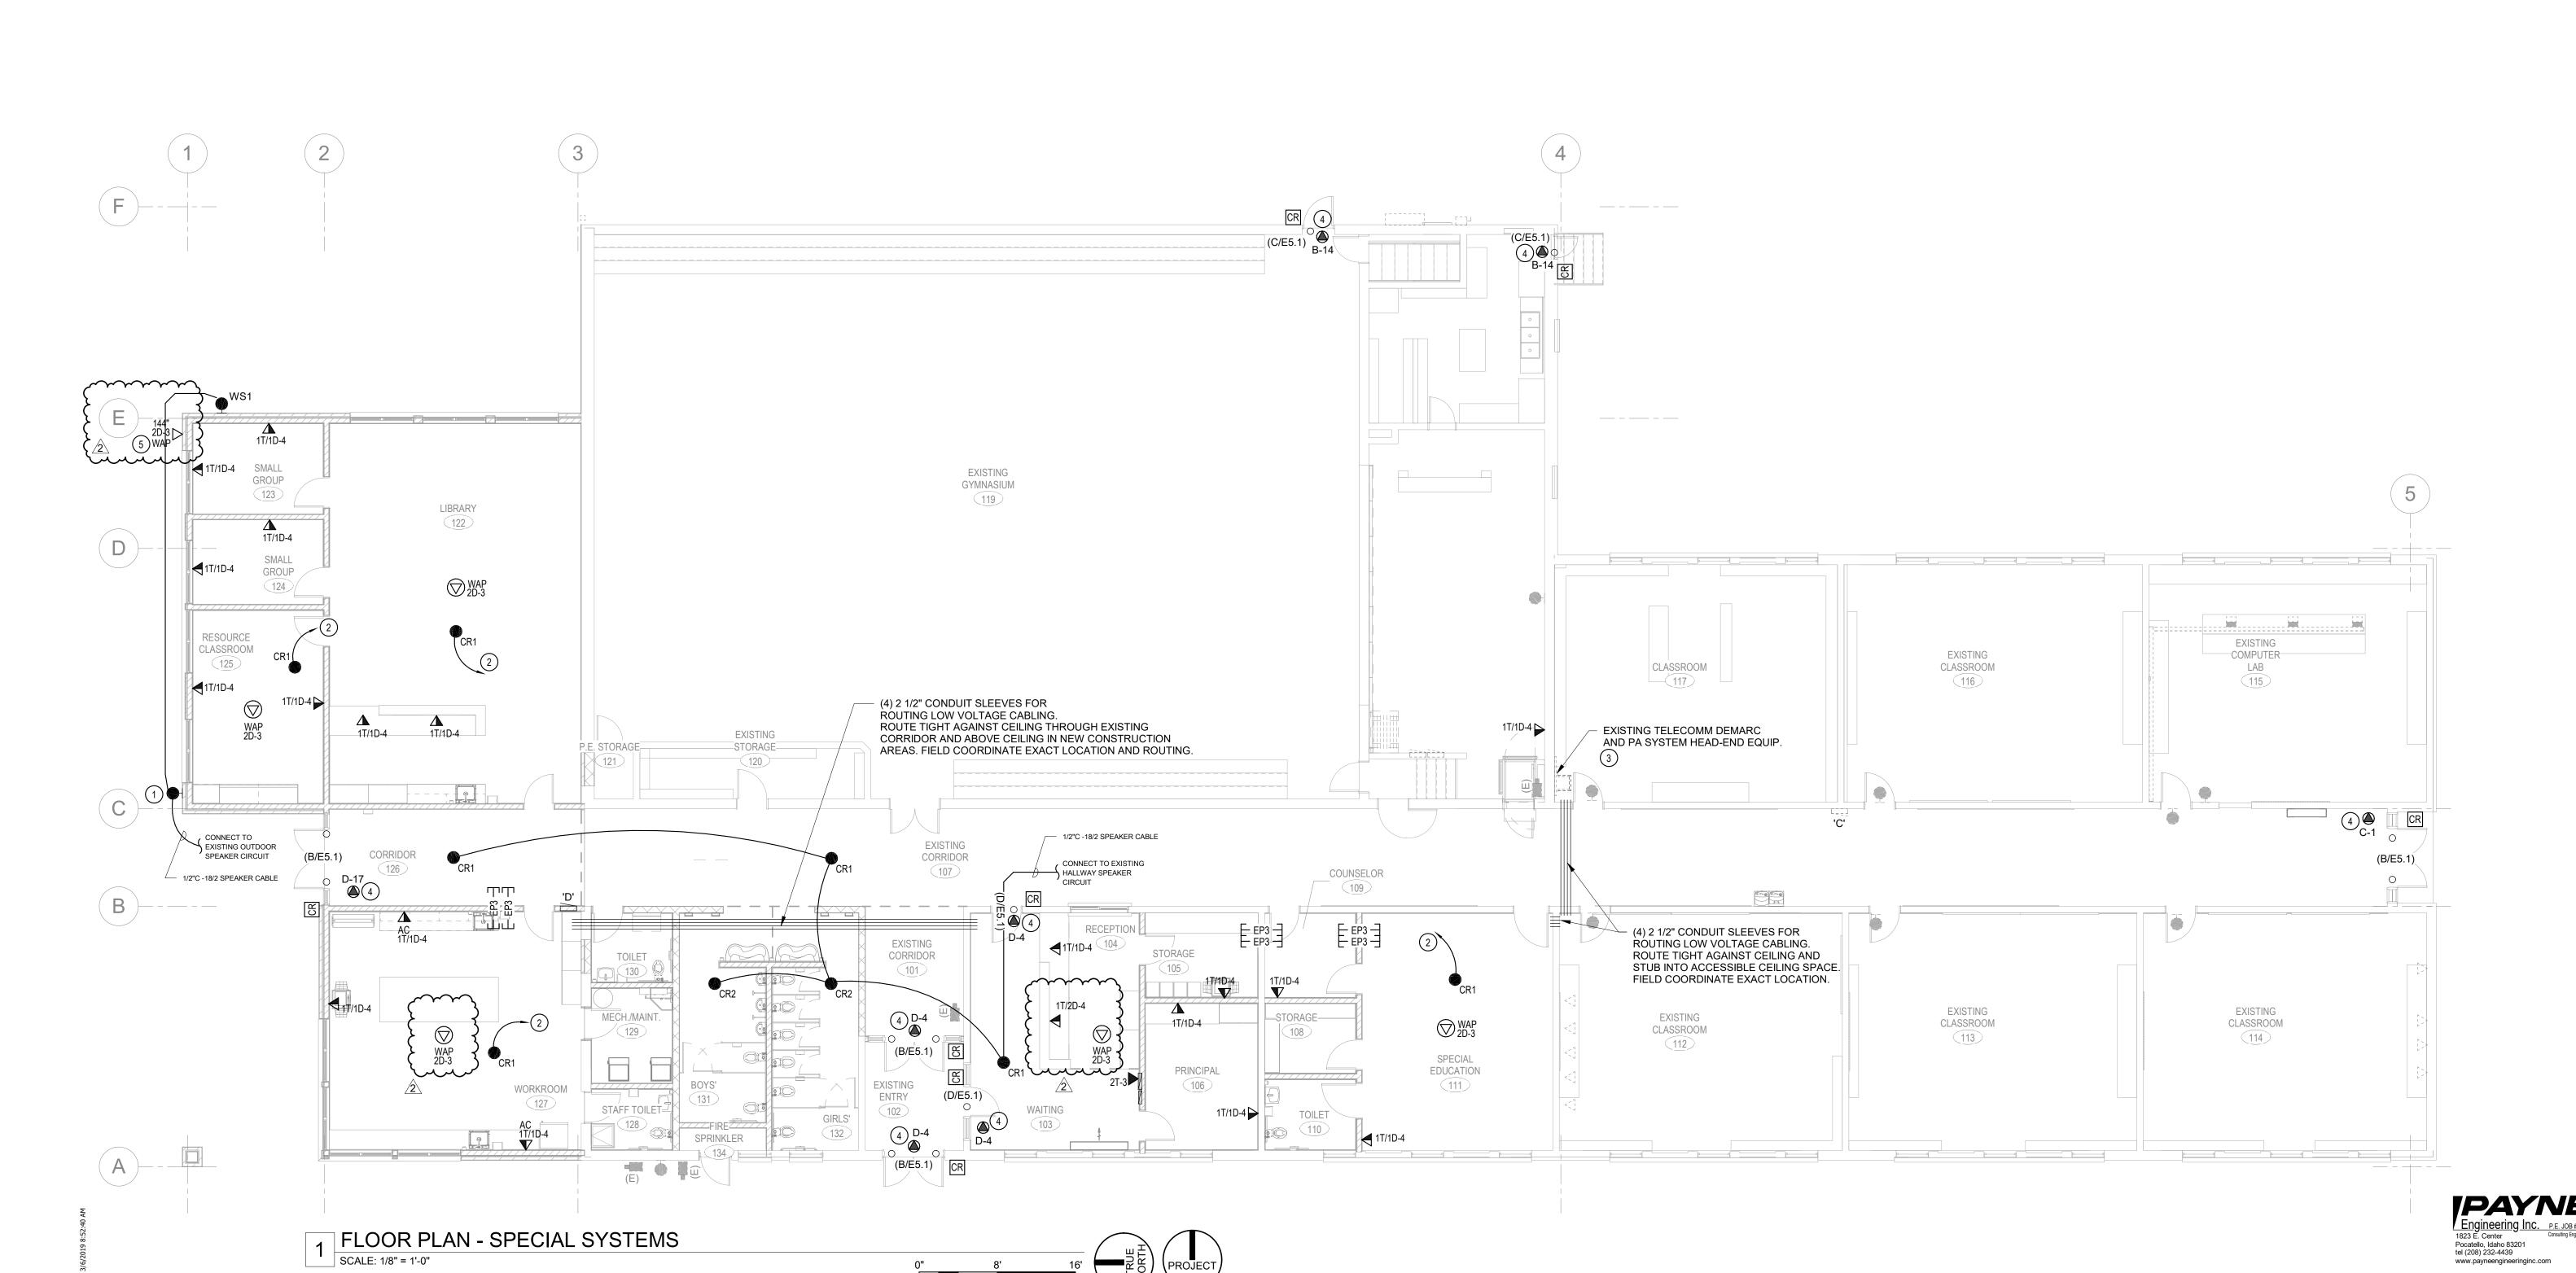

TETON SCHOOL DISTRI

revisions
no. description date
2 Addendum#1 03/08/2019

project: 1724

FLOOR PLAN SPECIAL
SYSTEMS

sheet:

E3.1